


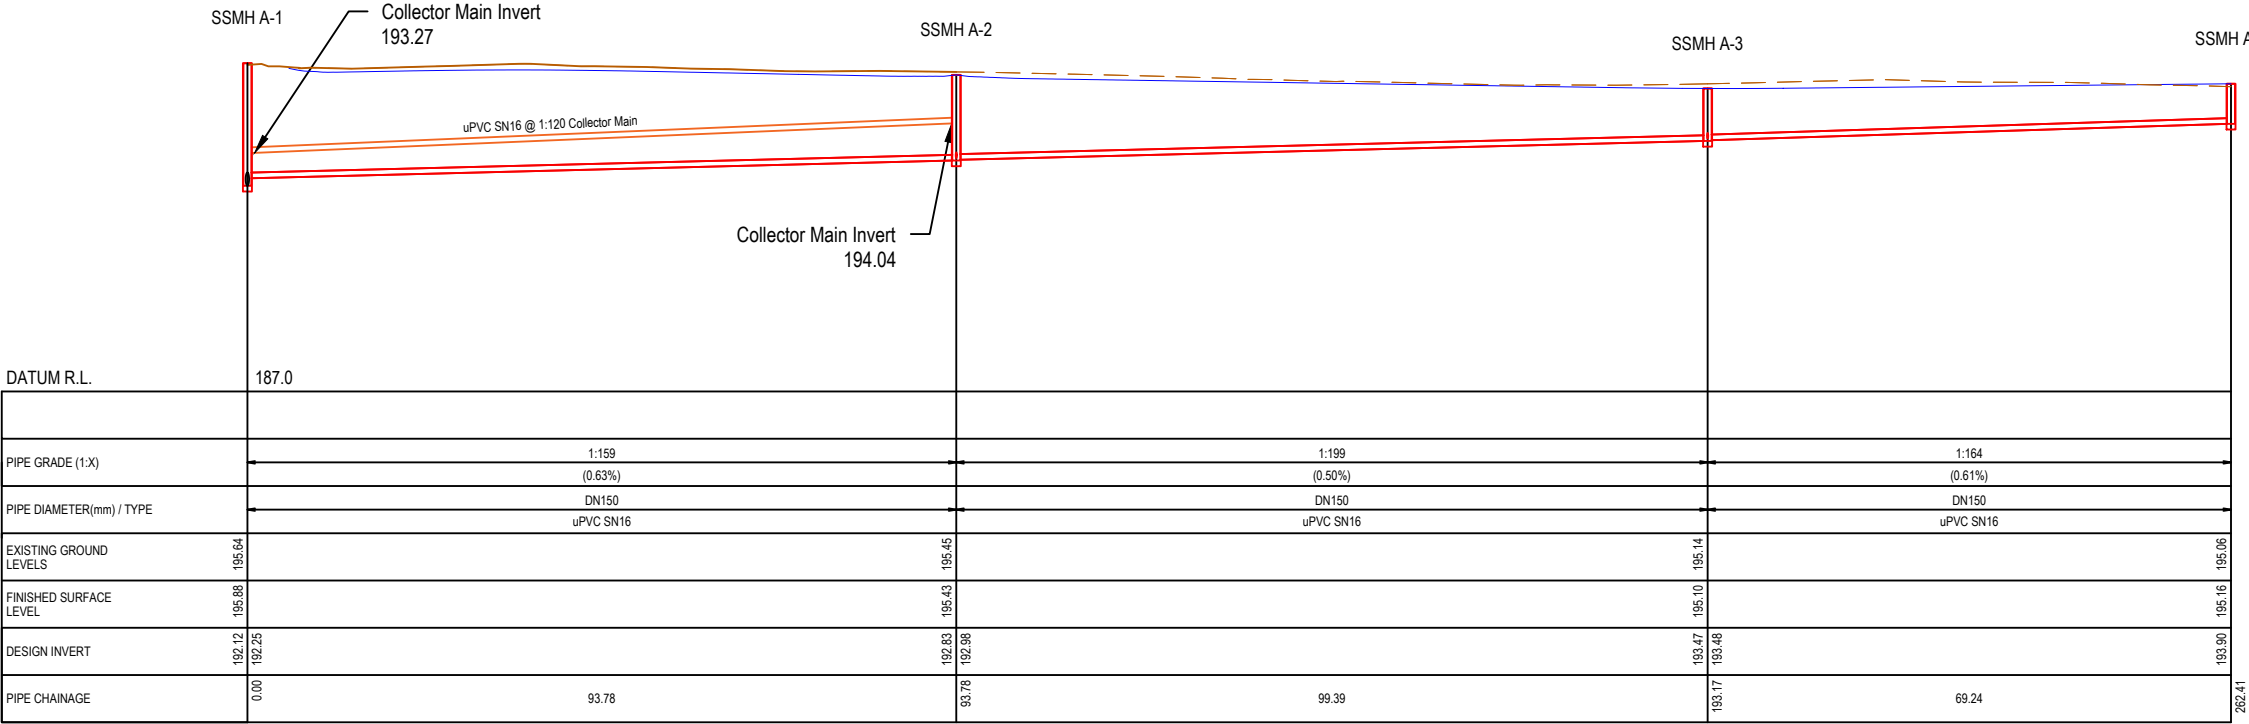

PIPELINE - A

This drawing remains the property of Capture Land Limited and may not be reproduced or amended without written permission. No liability shall be accepted for unauthorised use of this drawing.

CLIENT

DARFIELD
ESTATES GP
LIMITED


PROJECT

DARFIELD ESTATES STAGE 2




DATE	REVISION DETAILS	ISSUED
A 18/08/26	FOR COMPLETION	CH
DRAWING STATUS		
FOR COMPLETION		


DRAWING TITLE		
AS BUILT WASTEWATER LONG SECTIONS SHEET 1 OF 2		
PROJECT NO	SCALE	PLOT SIZE
1414		A3
DRAWING NO	REVISION	
1414-DR-C-9210	A	

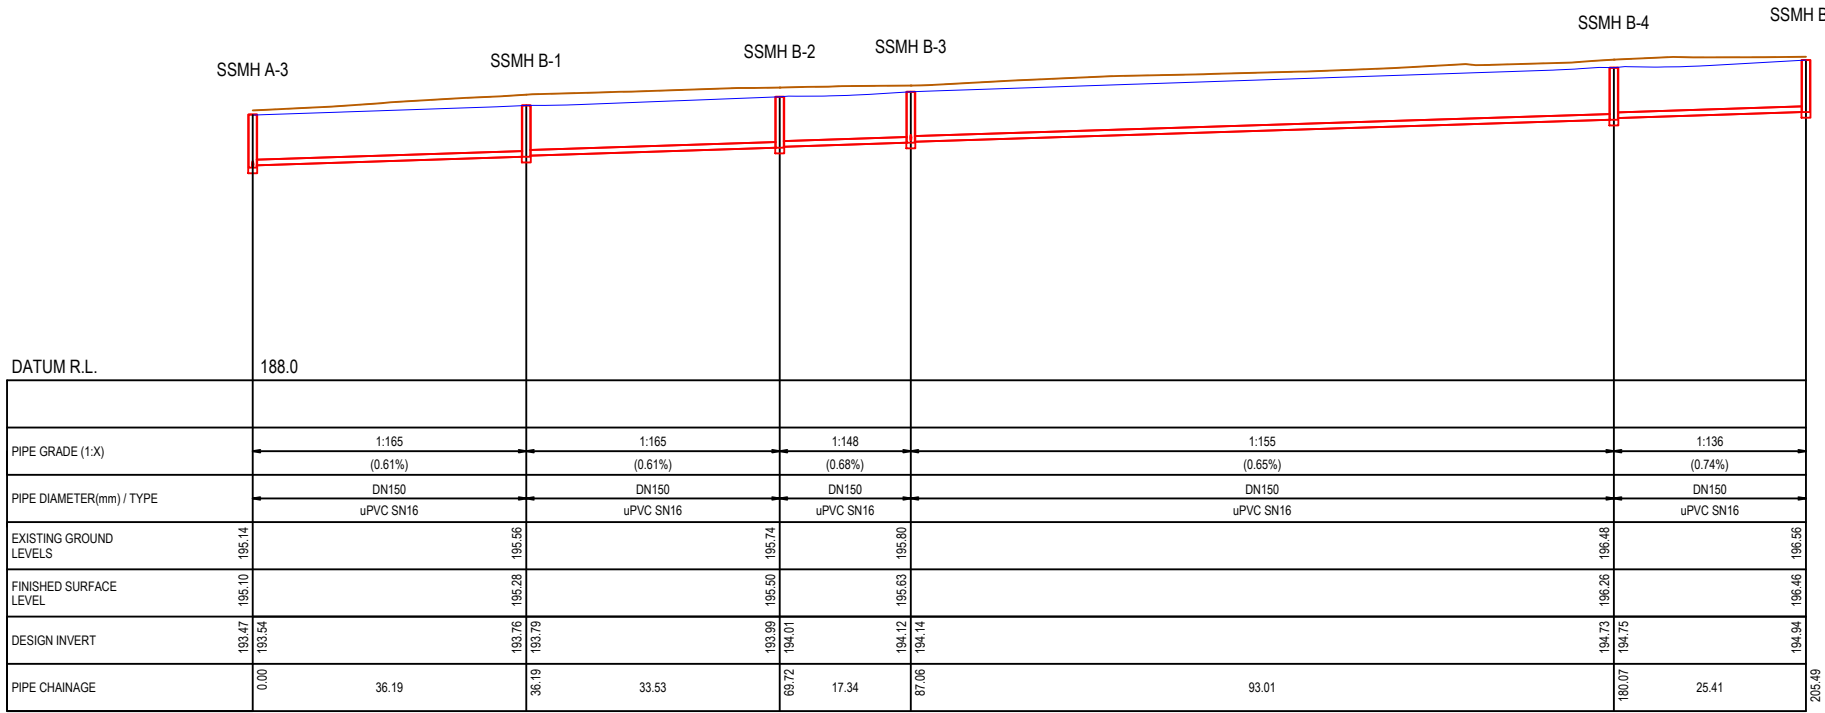

PIPELINE - B

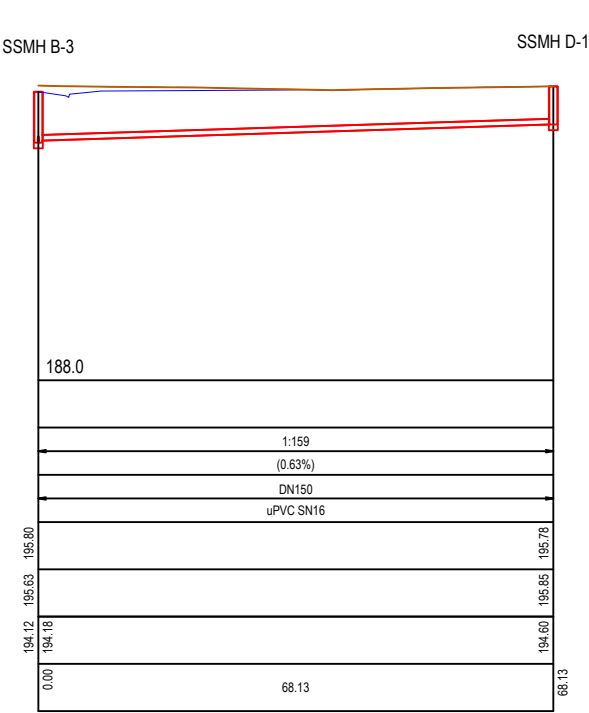

PIPELINE - D

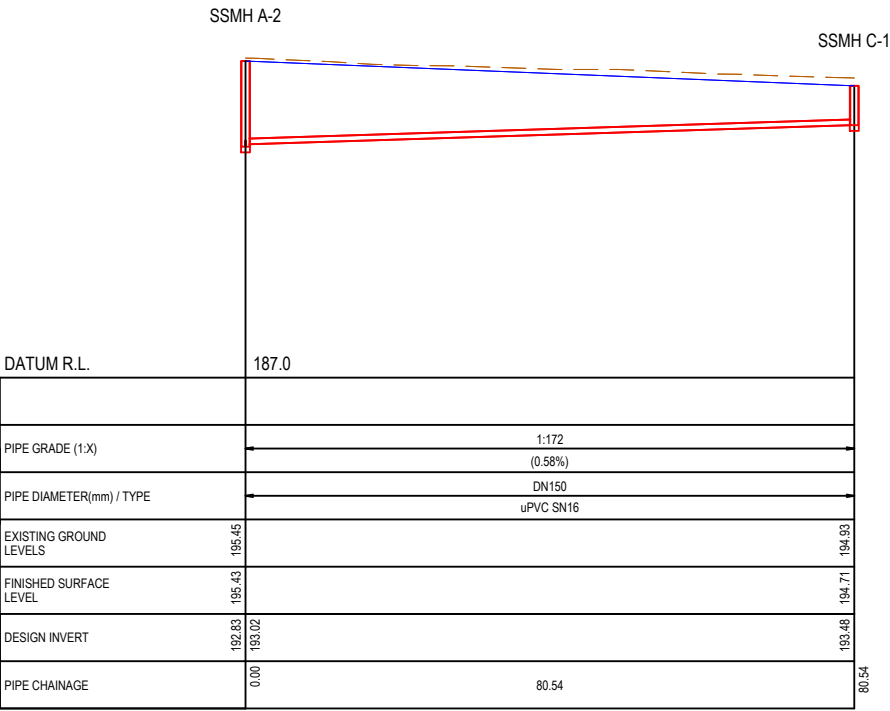

PIPELINE - C

This drawing remains the property of Capture Land Limited and may not be reproduced or amended without written permission. No liability shall be accepted for unauthorised use of this drawing.

CLIENT
DARFIELD ESTATES GP LIMITED

PROJECT
DARFIELD ESTATES STAGE 2



DATE	REVISION DETAILS	ISSUED
A 18/08/26	FOR COMPLETION	CH
DRAWING STATUS		
FOR COMPLETION		

DRAWING TITLE		
AS BUILT WASTEWATER LONG SECTIONS SHEET 2 OF 2		
PROJECT NO	SCALE	PLOT SIZE
1414		A3
DRAWING NO	REVISION	
1414-DR-C-9211	A	