



This drawing remains the property of Capture Land Limited and may not be reproduced or amended without written permission. No liability shall be accepted for unauthorised use of this drawing.

NOTES

- 1. ASBUILT INFORMATION HAS BEEN COLLECTED AND SUPPLIED BY ISAAC CONSTRUCTION LTD.

ORIGIN OF LEVELS: CC 301 (E04N)
REDUCED LEVEL: 196.1205m
VERTICAL DATUM: NZVD2016 (NOV 2018)

LEGEND:

- 37.00 — MAJOR CONTOURS (0.5m)
- MINOR CONTOURS (0.10m)
- 35.00 EXISTING GROUND LEVEL
- 35.00 FINISHED GROUND LEVEL

CLIENT

DARFIELD ESTATES GP LIMITED

PROJECT

DARFIELD ESTATES STAGE 2A



DATE	REVISION DETAILS	ISSUED
A 28/08/26	FOR COMPLETION	MC

DRAWING STATUS
FOR COMPLETION

DRAWING TITLE
AS BUILT CONTOURS
SHEET 1 OF 3

PROJECT NO	SCALE	PLOT SIZE
1414	1:2000	A3
DRAWING NO	REVISION	
1414-DR-9010	A	



This drawing remains the property of Capture Land Limited and may not be reproduced or amended without written permission. No liability shall be accepted for unauthorised use of this drawing.

NOTES

1. ASBUILT INFORMATION HAS BEEN COLLECTED AND SUPPLIED BY ISAAC CONSTRUCTION LTD.

ORIGIN OF LEVELS: CC 301 (E04N)
REDUCED LEVEL: 196.1205m
VERTICAL DATUM: NZVD2016 (NOV 2018)

LEGEND:

- 37.00 — MAJOR CONTOURS (0.5m)
— — MINOR CONTOURS (0.10m)
35.00 EXISTING GROUND LEVEL
35.00 FINISHED GROUND LEVEL

CLIENT

DARFIELD ESTATES GP LIMITED

PROJECT

DARFIELD ESTATES STAGE 2A




	DATE	REVISION DETAILS	ISSUED
A	28/08/26	FOR COMPLETION	MC

DRAWING STATUS
FOR COMPLETION

DRAWING TITLE
AS BUILT CONTOURS
SHEET 2 OF 3

PROJECT NO	SCALE	PLOT SIZE
1414	1:1000	A3
DRAWING NO	REVISION	
1414-DR-9011	A	

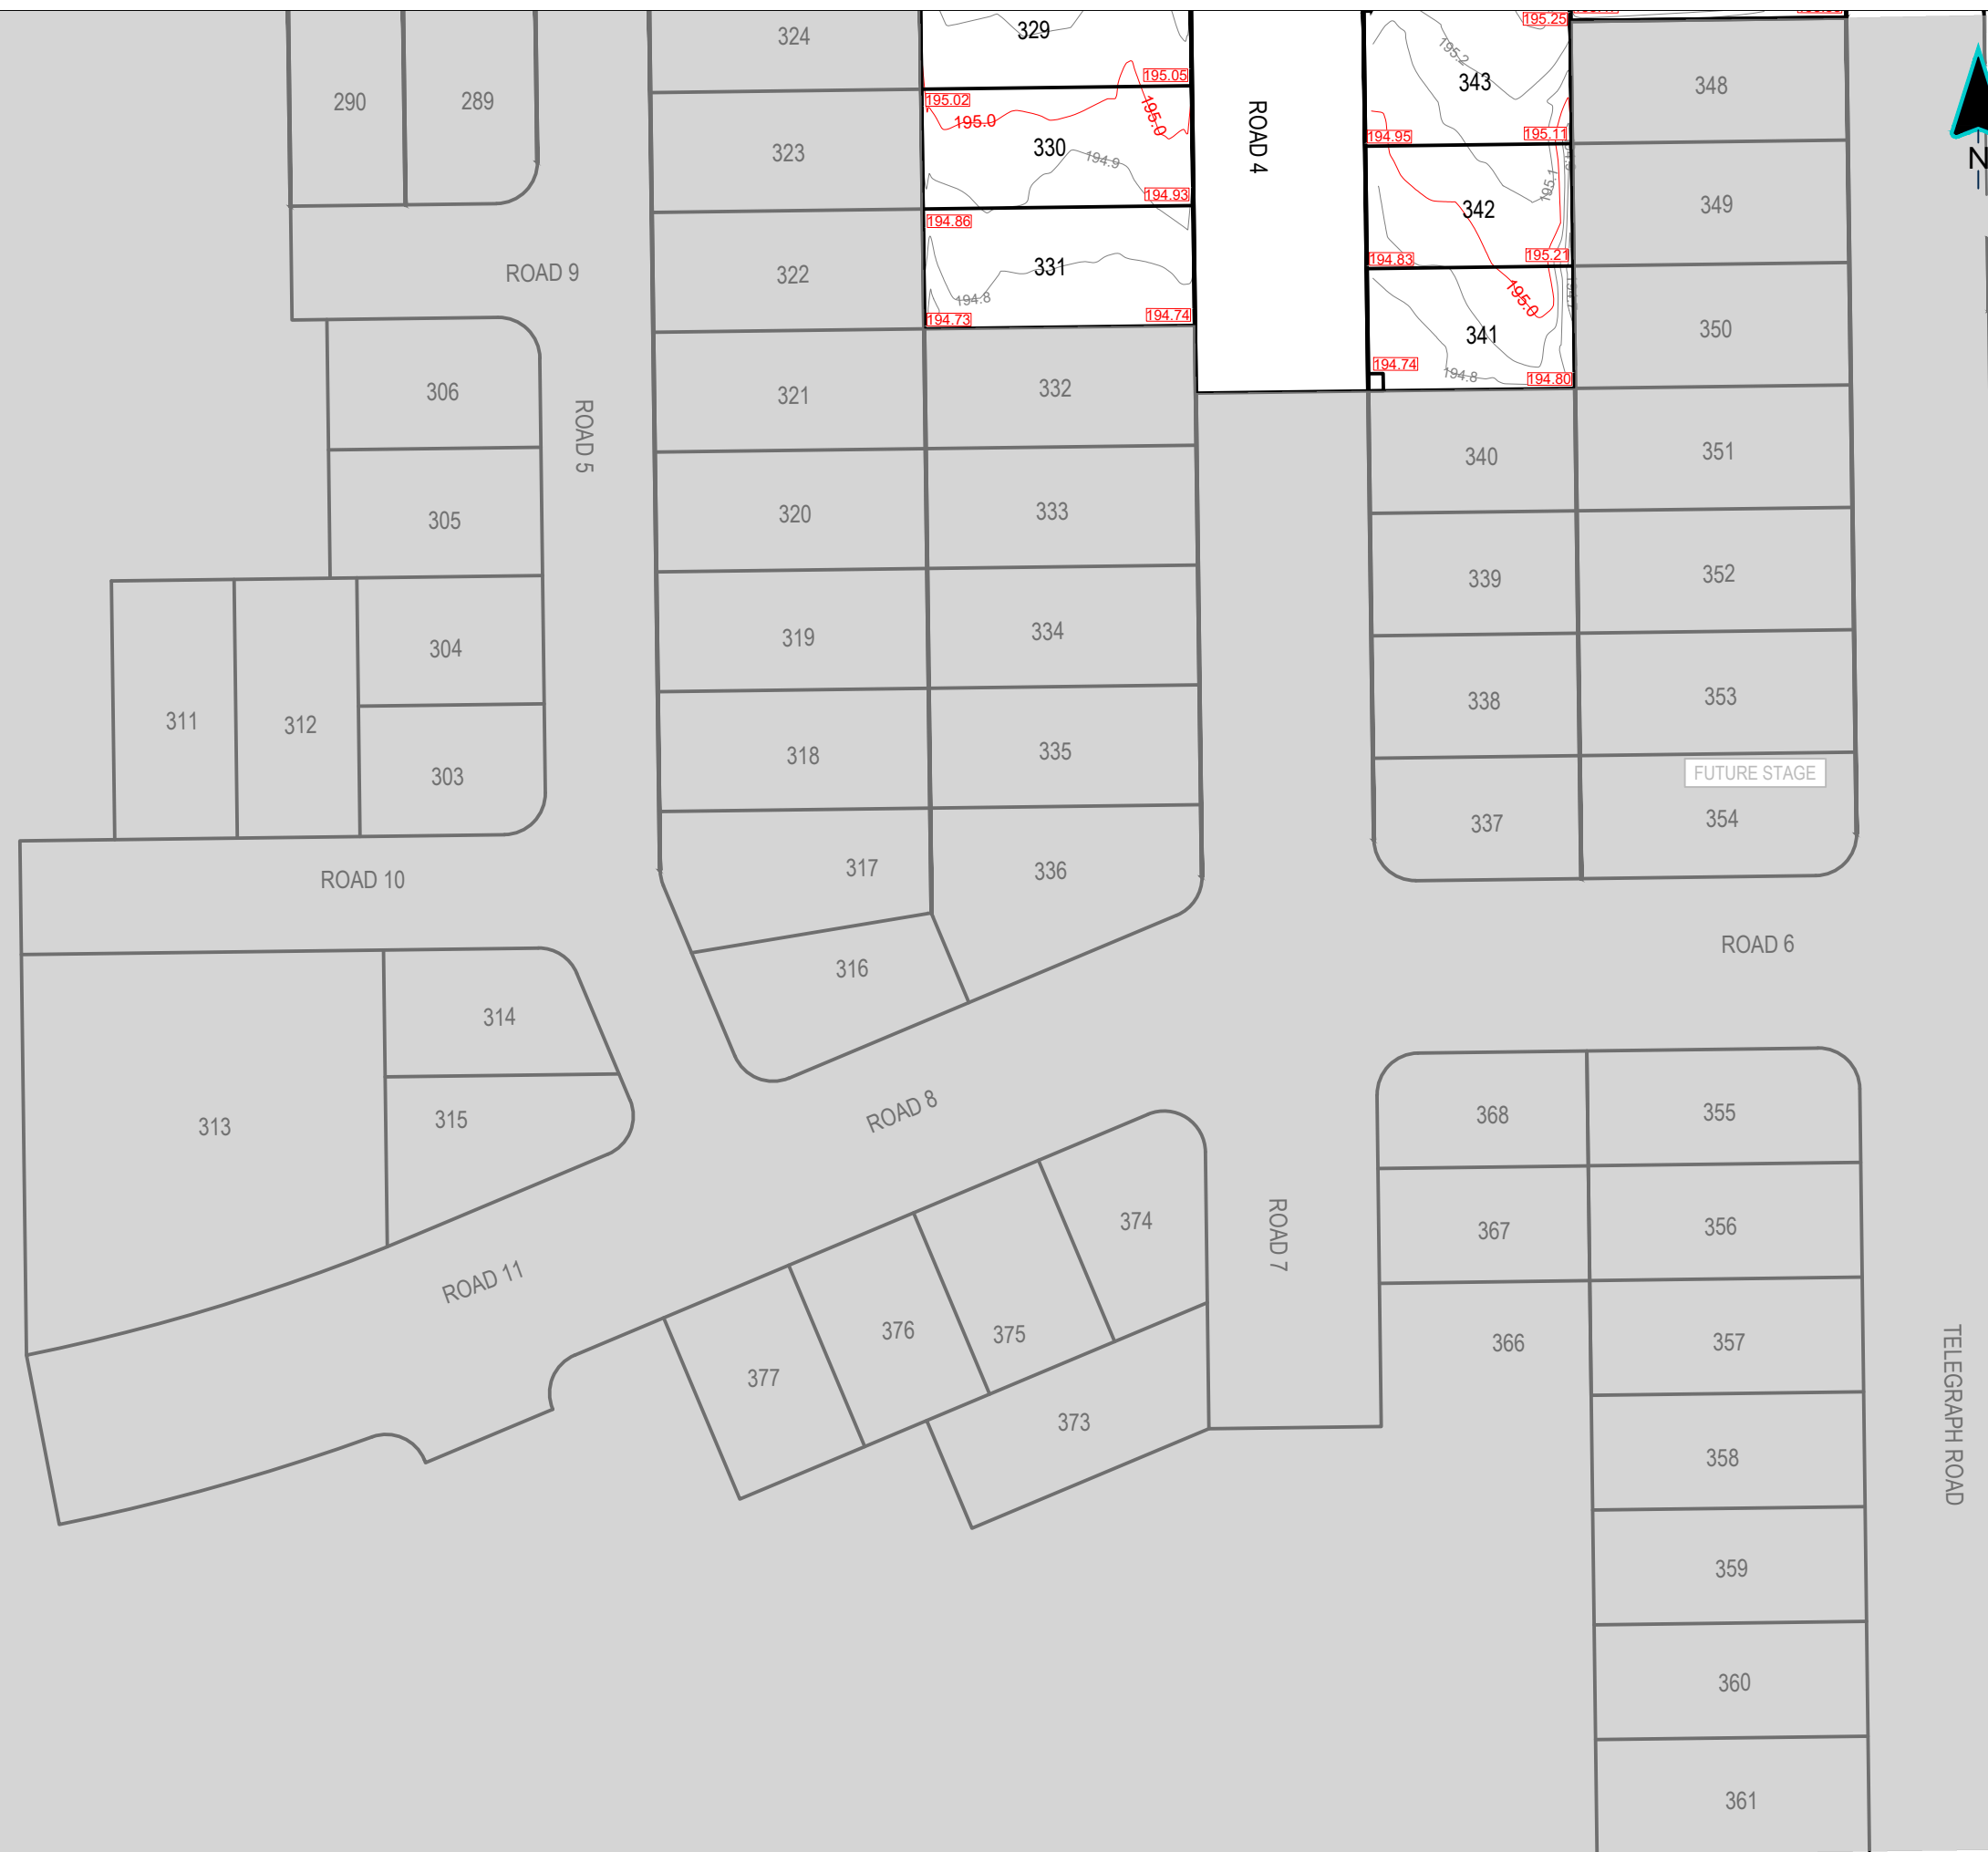

This drawing remains the property of Capture Land Limited and may not be reproduced or amended without written permission. No liability shall be accepted for unauthorised use of this drawing.

NOTES

1. ASBUILT INFORMATION HAS BEEN COLLECTED AND SUPPLIED BY ISAAC CONSTRUCTION LTD.

ORIGIN OF LEVELS:	CC 301 (E04N)
REDUCED LEVEL:	196.1205m
VERTICAL DATUM:	NZVD2016 (NOV 2018)

LEGEND:

— 37.00 —	MAJOR CONTOURS (0.5m)
—————	MINOR CONTOURS (0.10m)
35.00	EXISTING GROUND LEVEL
35.00	FINISHED GROUND LEVEL

CLIENT

DARFIELD ESTATES GP LIMITED

PROJECT

DARFIELD ESTATES STAGE 2A

[illegible]

			DRAWING STATUS
--	--	--	----------------

FOR COMPLETION

DRAWING TITLE

AS BUILT CONTOURS
SHEET 3 OF 3

PROJECT NO	SCALE	PLOT SIZE
1111	1:1000	A3

DRAWING NO	REVISION
1414-DR-9012	A