




NOTES:
THIS DRAWING IS THE PROPERTY AND COPYRIGHT OF KIRK ROBERTS CONSULTING ENGINEERS LTD AND SHALL NOT BE COPIED REPRODUCED OR COMMUNICATED TO A THIRD PARTY WITHOUT WRITTEN CONSENT (C) 2017.

THIS DRAWING TO BE READ IN CONJUNCTION WITH THE LATEST DRAWINGS AND SPECIFICATIONS FROM ALL OTHER DISCIPLINES. PROJECT MANAGER TO BE NOTIFIED OF ANY VARIATION BETWEEN SITE DIMENSIONS AND THOSE ON DRAWINGS ALL DIMENSIONS ARE SHOWN IN METRES UNLESS OTHERWISE STATED.

THIS PLAN IS FOR AS BUILT PURPOSES ONLY.

TELEGRAPH ROAD

OWEN DRIVE

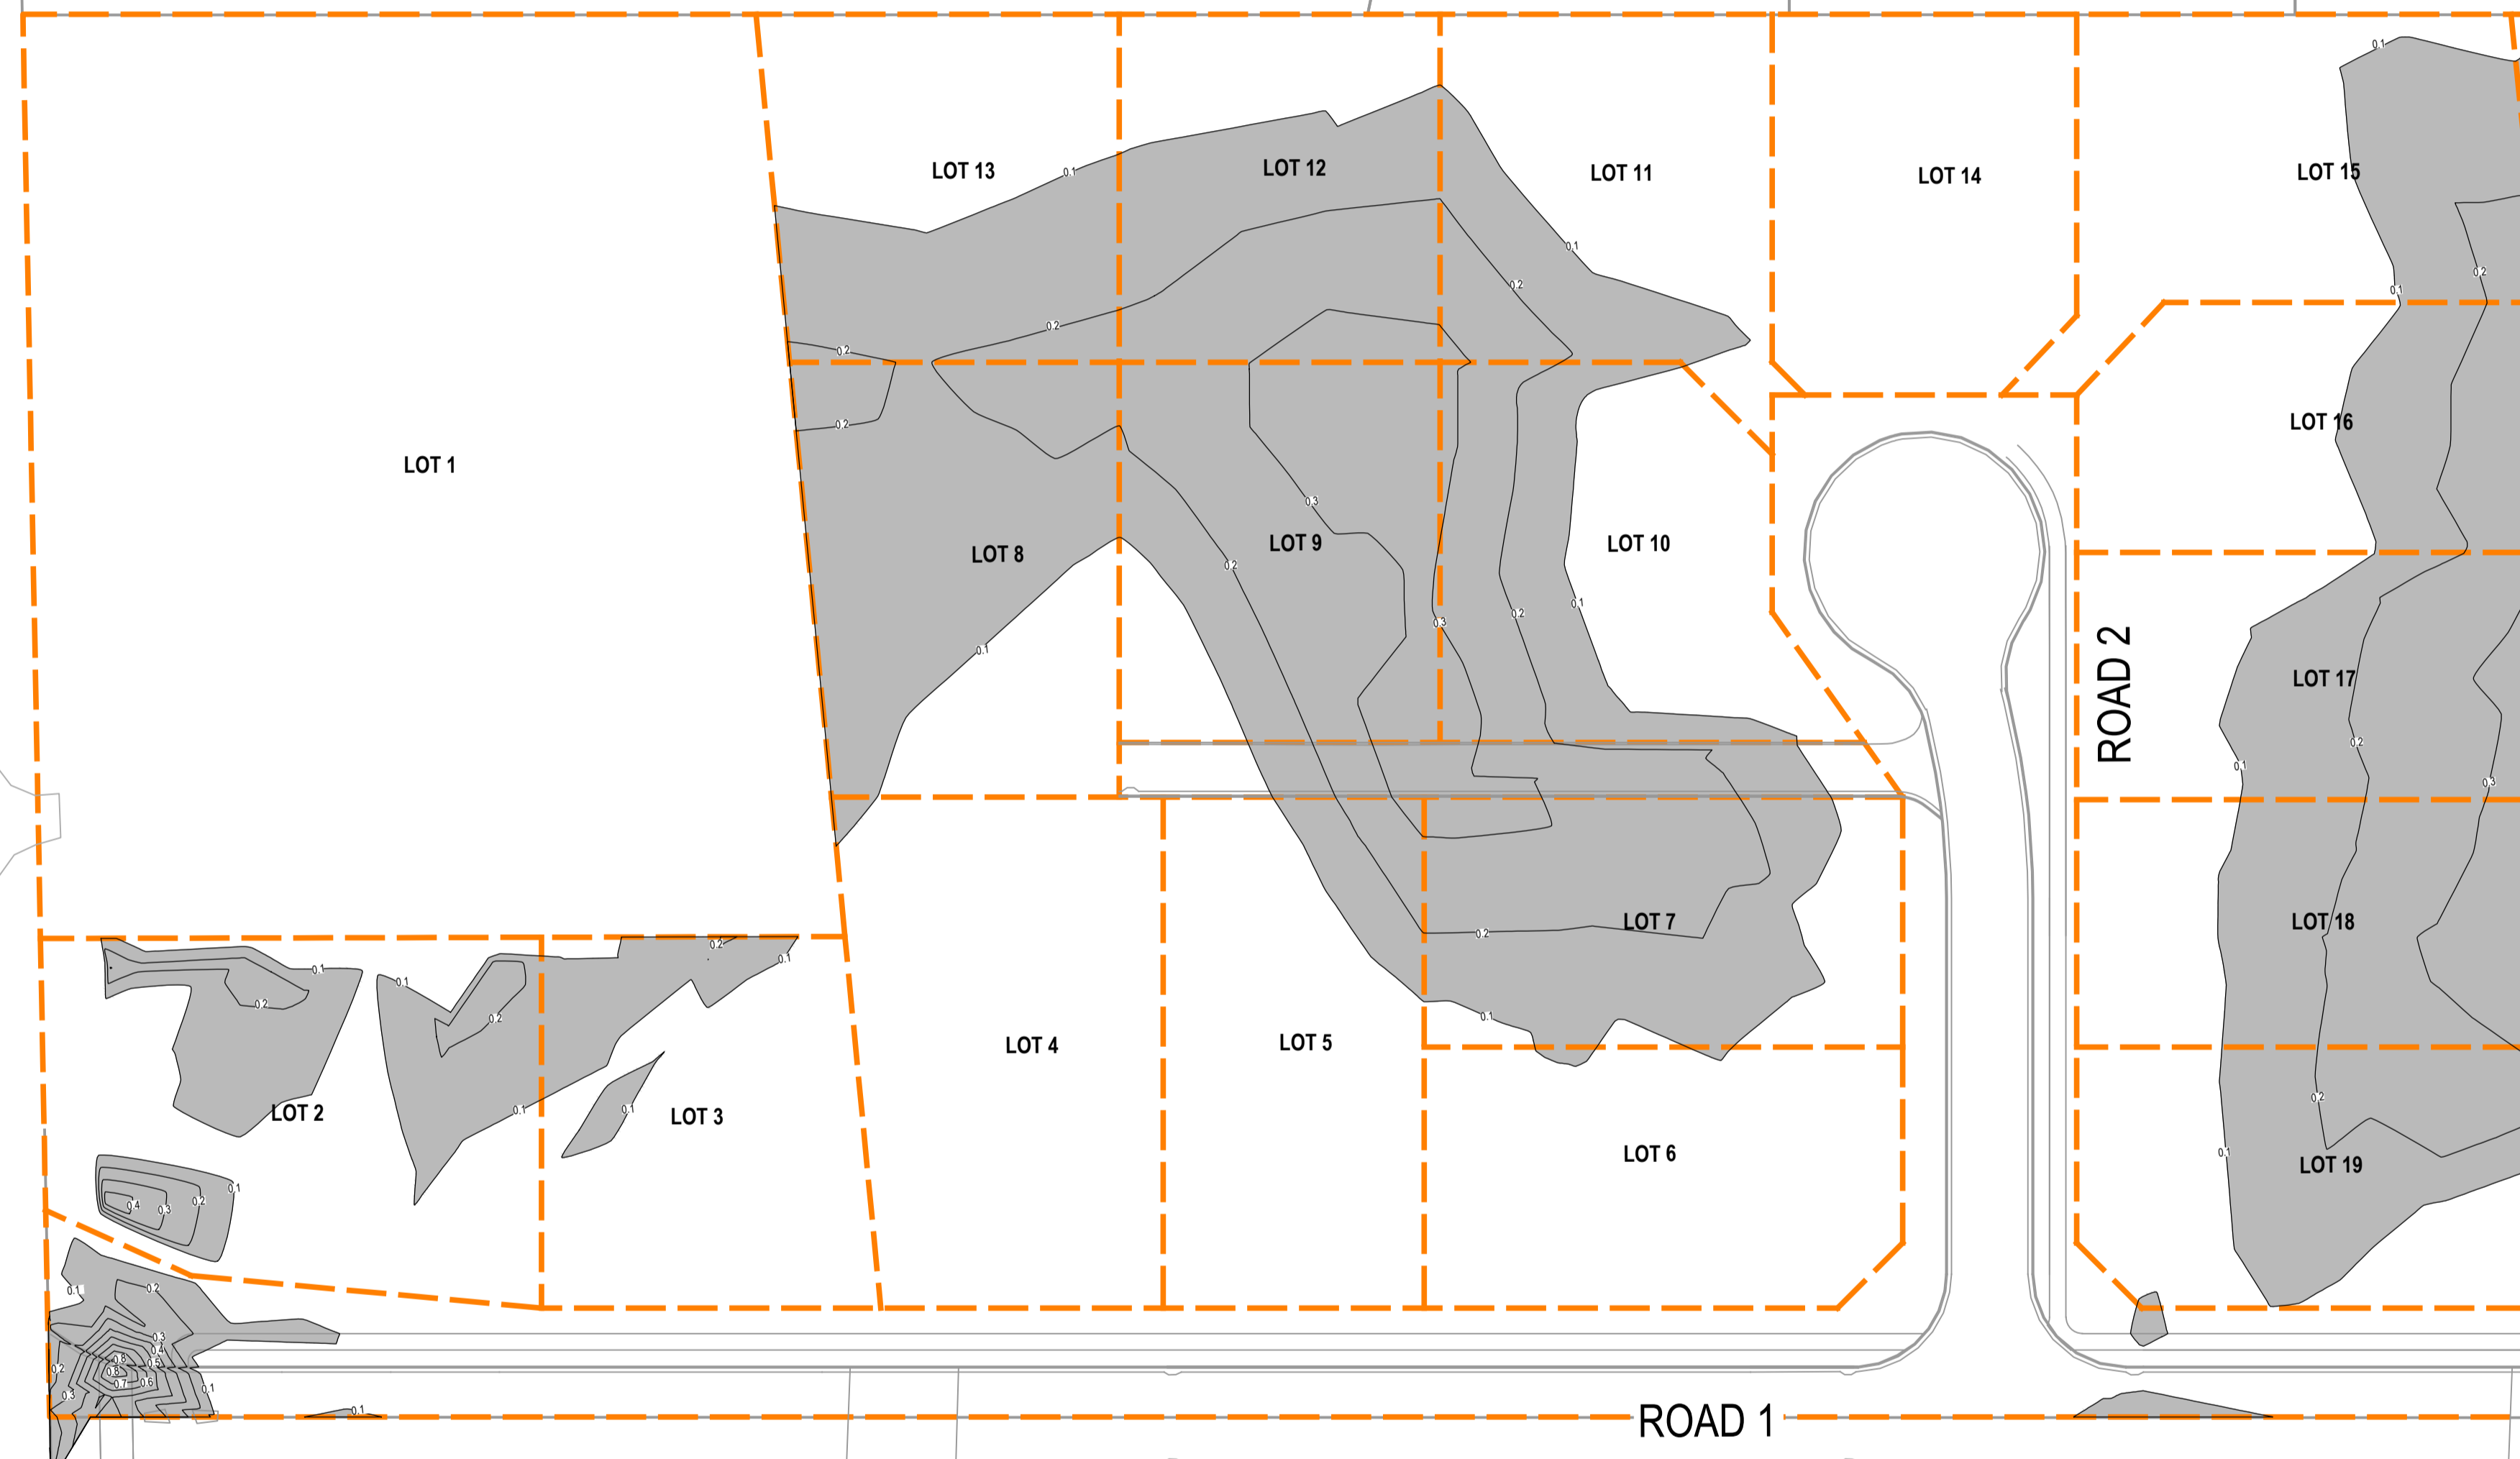

A	03-05-2022	AS BUILT	DM
REV	DATE	ISSUED FOR	BY

PROJECT
1920 TELEGRAPH ROAD
DARFIELD

CLIENT
EAST WEST DEVELOPMENTS LTD

TITLE
FILL AS BUILTS
DRAWING 1 OF 2

REVIEWED BY: DM 03-05-2022

DESIGNED BY: BW

DRAWN BY: BW

SCALE: 1:500 (A1) JOB NO.: 2110455

DRAWING NO.: FILL_AB.1 REV.: A

AS BUILT

SCALE 1:500 (A1) 0 10 20 30 40 50m

THIS IS A COLOUR DRAWING



Cadd File: Z:\PROJ_2021\1045-1920_TELEGRAPH_ROADS_DELIVERY\8_DRAFT\CIVIL\1920-TELEGRAPH-FILL_ABDWG_Plot Date: 5/10/2022 3:49:22 pm. Name: Ben Williams Xref:

NOTES:
THIS DRAWING IS THE PROPERTY AND COPYRIGHT OF KIRK ROBERTS CONSULTING ENGINEERS LTD AND SHALL NOT BE COPIED REPRODUCED OR COMMUNICATED TO A THIRD PARTY WITHOUT WRITTEN CONSENT (C) 2017.

THIS DRAWING TO BE READ IN CONJUNCTION WITH THE LATEST DRAWINGS AND SPECIFICATIONS FROM ALL OTHER DISCIPLINES. PROJECT MANAGER TO BE NOTIFIED OF ANY VARIATION BETWEEN SITE DIMENSIONS AND THOSE ON DRAWINGS ALL DIMENSIONS ARE SHOWN IN METRES UNLESS OTHERWISE STATED.

THIS PLAN IS FOR AS BUILT PURPOSES ONLY.



REV	DATE	ISSUED FOR	DM	BY
A	03-05-2022	AS BUILT		

PROJECT
1920 TELEGRAPH ROAD
DARFIELD

CLIENT
EAST WEST DEVELOPMENTS LTD

TITLE
FILL AS BUILTS
DRAWING 2 OF 2

REVIEWED BY: DM 03-05-2022

DESIGNED BY: BW

DRAWN BY: BW

SCALE: 1:500 (A1) JOB NO.: 2110455

DRAWING NO.: REV.:

FILL_AB.2 A

AS BUILT

SCALE 1:500 (A1) 0 10 20 30 40 50m



Cadd File: Z:\PROJ_2021\1045-1920_TELEGRAPH_ROADS_DELIVERY\8_DRAFT\CIVIL\1920-TELEGRAPH-ROADS-FILL-AB.DWG Plot Date: 5/10/2022 3:49:27 pm Name: Ben Williams Xref:




NOTES:
THIS DRAWING IS THE PROPERTY AND COPYRIGHT OF KIRK ROBERTS CONSULTING ENGINEERS LTD AND SHALL NOT BE COPIED REPRODUCED OR COMMUNICATED TO A THIRD PARTY WITHOUT WRITTEN CONSENT (C) 2017.

THIS DRAWING TO BE READ IN CONJUNCTION WITH THE LATEST DRAWINGS AND SPECIFICATIONS FROM ALL OTHER DISCIPLINES. PROJECT MANAGER TO BE NOTIFIED OF ANY VARIATION BETWEEN SITE DIMENSIONS AND THOSE ON DRAWINGS ALL DIMENSIONS ARE SHOWN IN METRES UNLESS OTHERWISE STATED.

THIS PLAN IS FOR AS BUILT PURPOSES ONLY.

TELEGRAPH ROAD

OWEN DRIVE

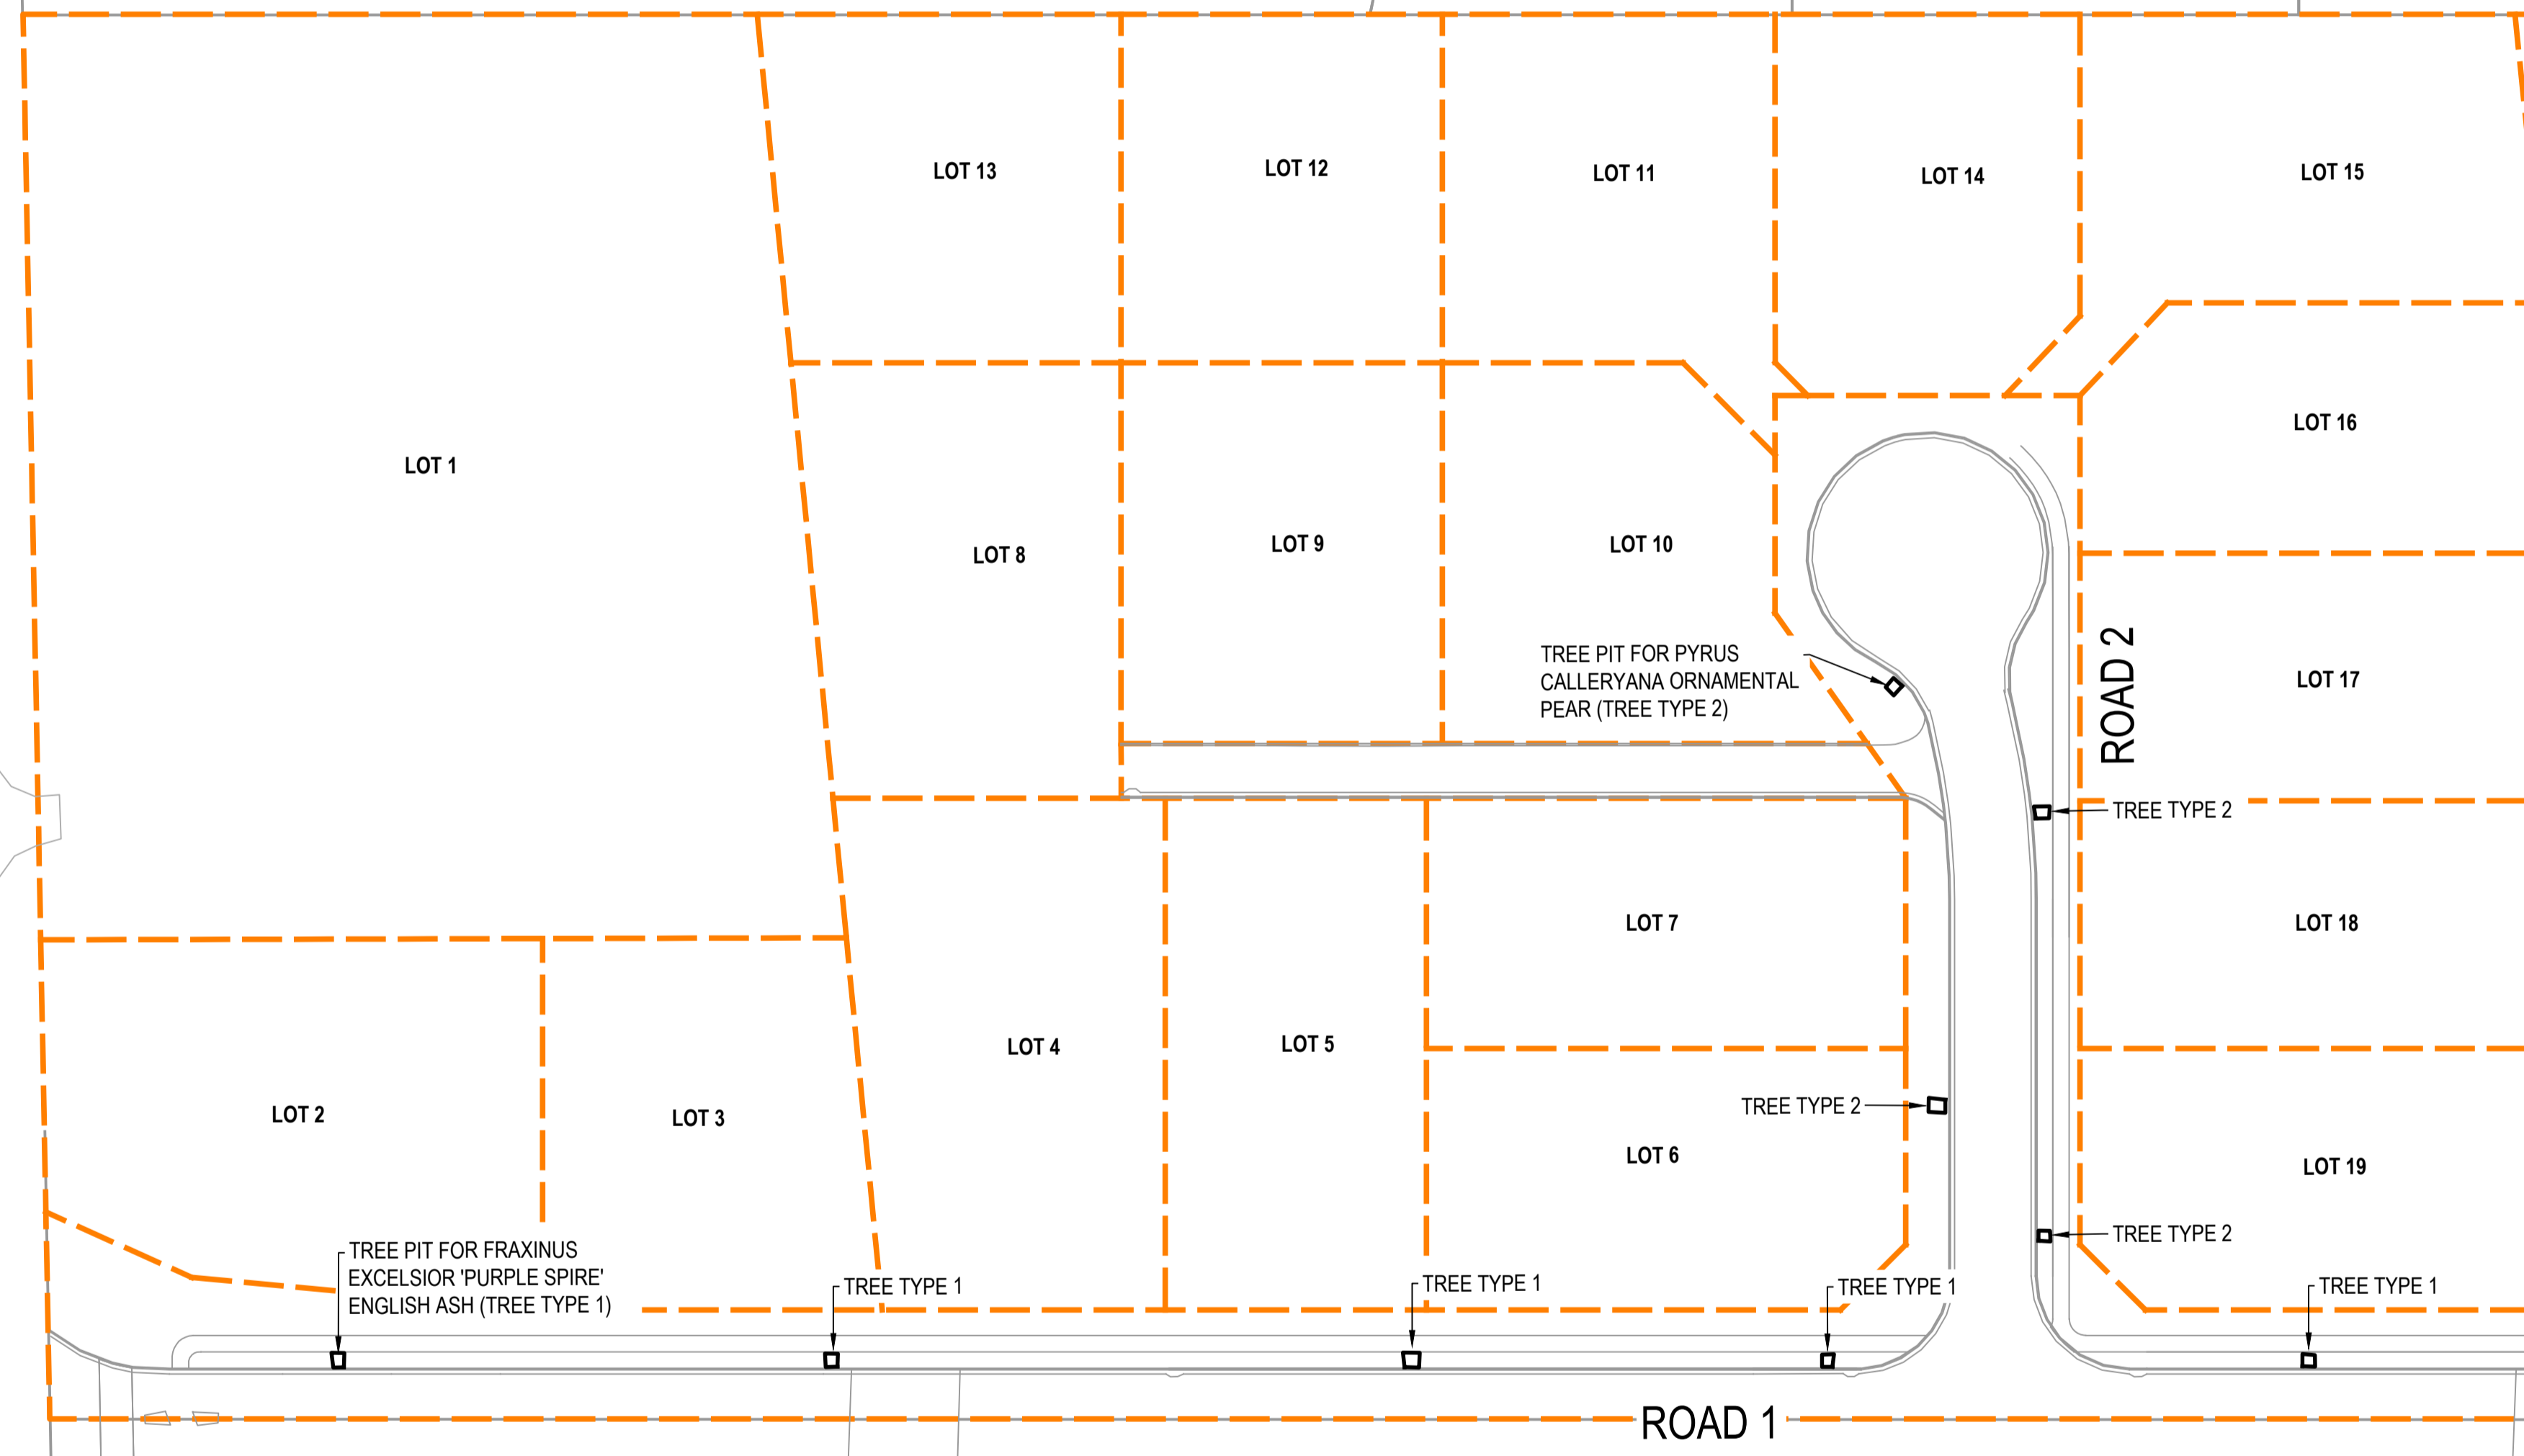

A	03-05-2022	AS BUILT	DM
REV	DATE	ISSUED FOR	BY

PROJECT
1920 TELEGRAPH ROAD
DARFIELD

CLIENT
EAST WEST DEVELOPMENTS LTD

TITLE
LANDSCAPING AS BUILTS
DRAWING 1 OF 2

REVIEWED BY: DM 03-05-2022

DESIGNED BY: BW

DRAWN BY: BW

SCALE: 1:500 (A1) JOB NO.: 2110455


DRAWING NO.: REV.

FILL_AB.1 A

AS BUILT

SCALE 1:500 (A1) 0 10 20 30 40 50m

THIS IS A COLOUR DRAWING

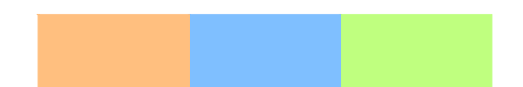

Cadd File: Z:\PROJ_2021\1045-1920_TELEGRAPH_Roads_DELIVERY8_DRAFT\CVL1210455-LANDSCAPING_AB.DWG Pld Date: 5/10/2022 3:50:56 pm Name: Ben Williams Xrefs:

NOTES:
THIS DRAWING IS THE PROPERTY AND COPYRIGHT OF KIRK ROBERTS CONSULTING ENGINEERS LTD AND SHALL NOT BE COPIED REPRODUCED OR COMMUNICATED TO A THIRD PARTY WITHOUT WRITTEN CONSENT (C) 2017.

THIS DRAWING TO BE READ IN CONJUNCTION WITH THE LATEST DRAWINGS AND SPECIFICATIONS FROM ALL OTHER DISCIPLINES. PROJECT MANAGER TO BE NOTIFIED OF ANY VARIATION BETWEEN SITE DIMENSIONS AND THOSE ON DRAWINGS ALL DIMENSIONS ARE SHOWN IN METRES UNLESS OTHERWISE STATED.

THIS PLAN IS FOR AS BUILT PURPOSES ONLY.



A	03-05-2022	AS BUILT	DM
REV	DATE	ISSUED FOR	BY

PROJECT
1920 TELEGRAPH ROAD
DARFIELD

CLIENT
EAST WEST DEVELOPMENTS LTD

TITLE
LANDSCAPING AS BUILTS
DRAWING 2 OF 2

REVIEWED BY: DM 03-05-2022

DESIGNED BY: BW



DRAWN BY: BW

SCALE: 1:500 (A1) JOB NO.: 2110455

DRAWING NO.: REV.

FILL_AB.2 A

AS BUILT

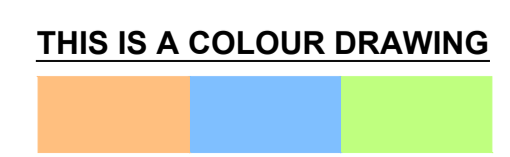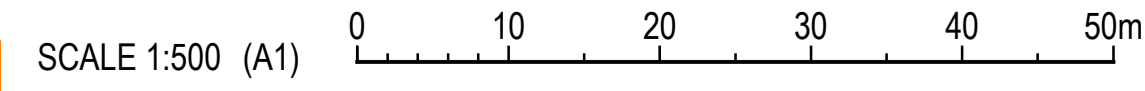

Cadd File: Z:\PROJ_2021\1045-1920_TELEGRAPH_Roads_DELIVERY8_DRAFT\CIVIL\1920-AS-BUILT-LANDSCAPING_AB.DWG Pld Date: 5/10/2022 3:51:15 pm Name: Ben Williams Xref:




NOTES:
THIS DRAWING IS THE PROPERTY AND COPYRIGHT OF KIRK ROBERTS CONSULTING ENGINEERS LTD AND SHALL NOT BE COPIED REPRODUCED OR COMMUNICATED TO A THIRD PARTY WITHOUT WRITTEN CONSENT (C) 2017.

THIS DRAWING TO BE READ IN CONJUNCTION WITH THE LATEST DRAWINGS AND SPECIFICATIONS FROM ALL OTHER DISCIPLINES. PROJECT MANAGER TO BE NOTIFIED OF ANY VARIATION BETWEEN SITE DIMENSIONS AND THOSE ON DRAWINGS ALL DIMENSIONS ARE SHOWN IN METRES UNLESS OTHERWISE STATED.

THIS PLAN IS FOR AS BUILT PURPOSES ONLY.

TELEGRAPH ROAD

OWEN DRIVE

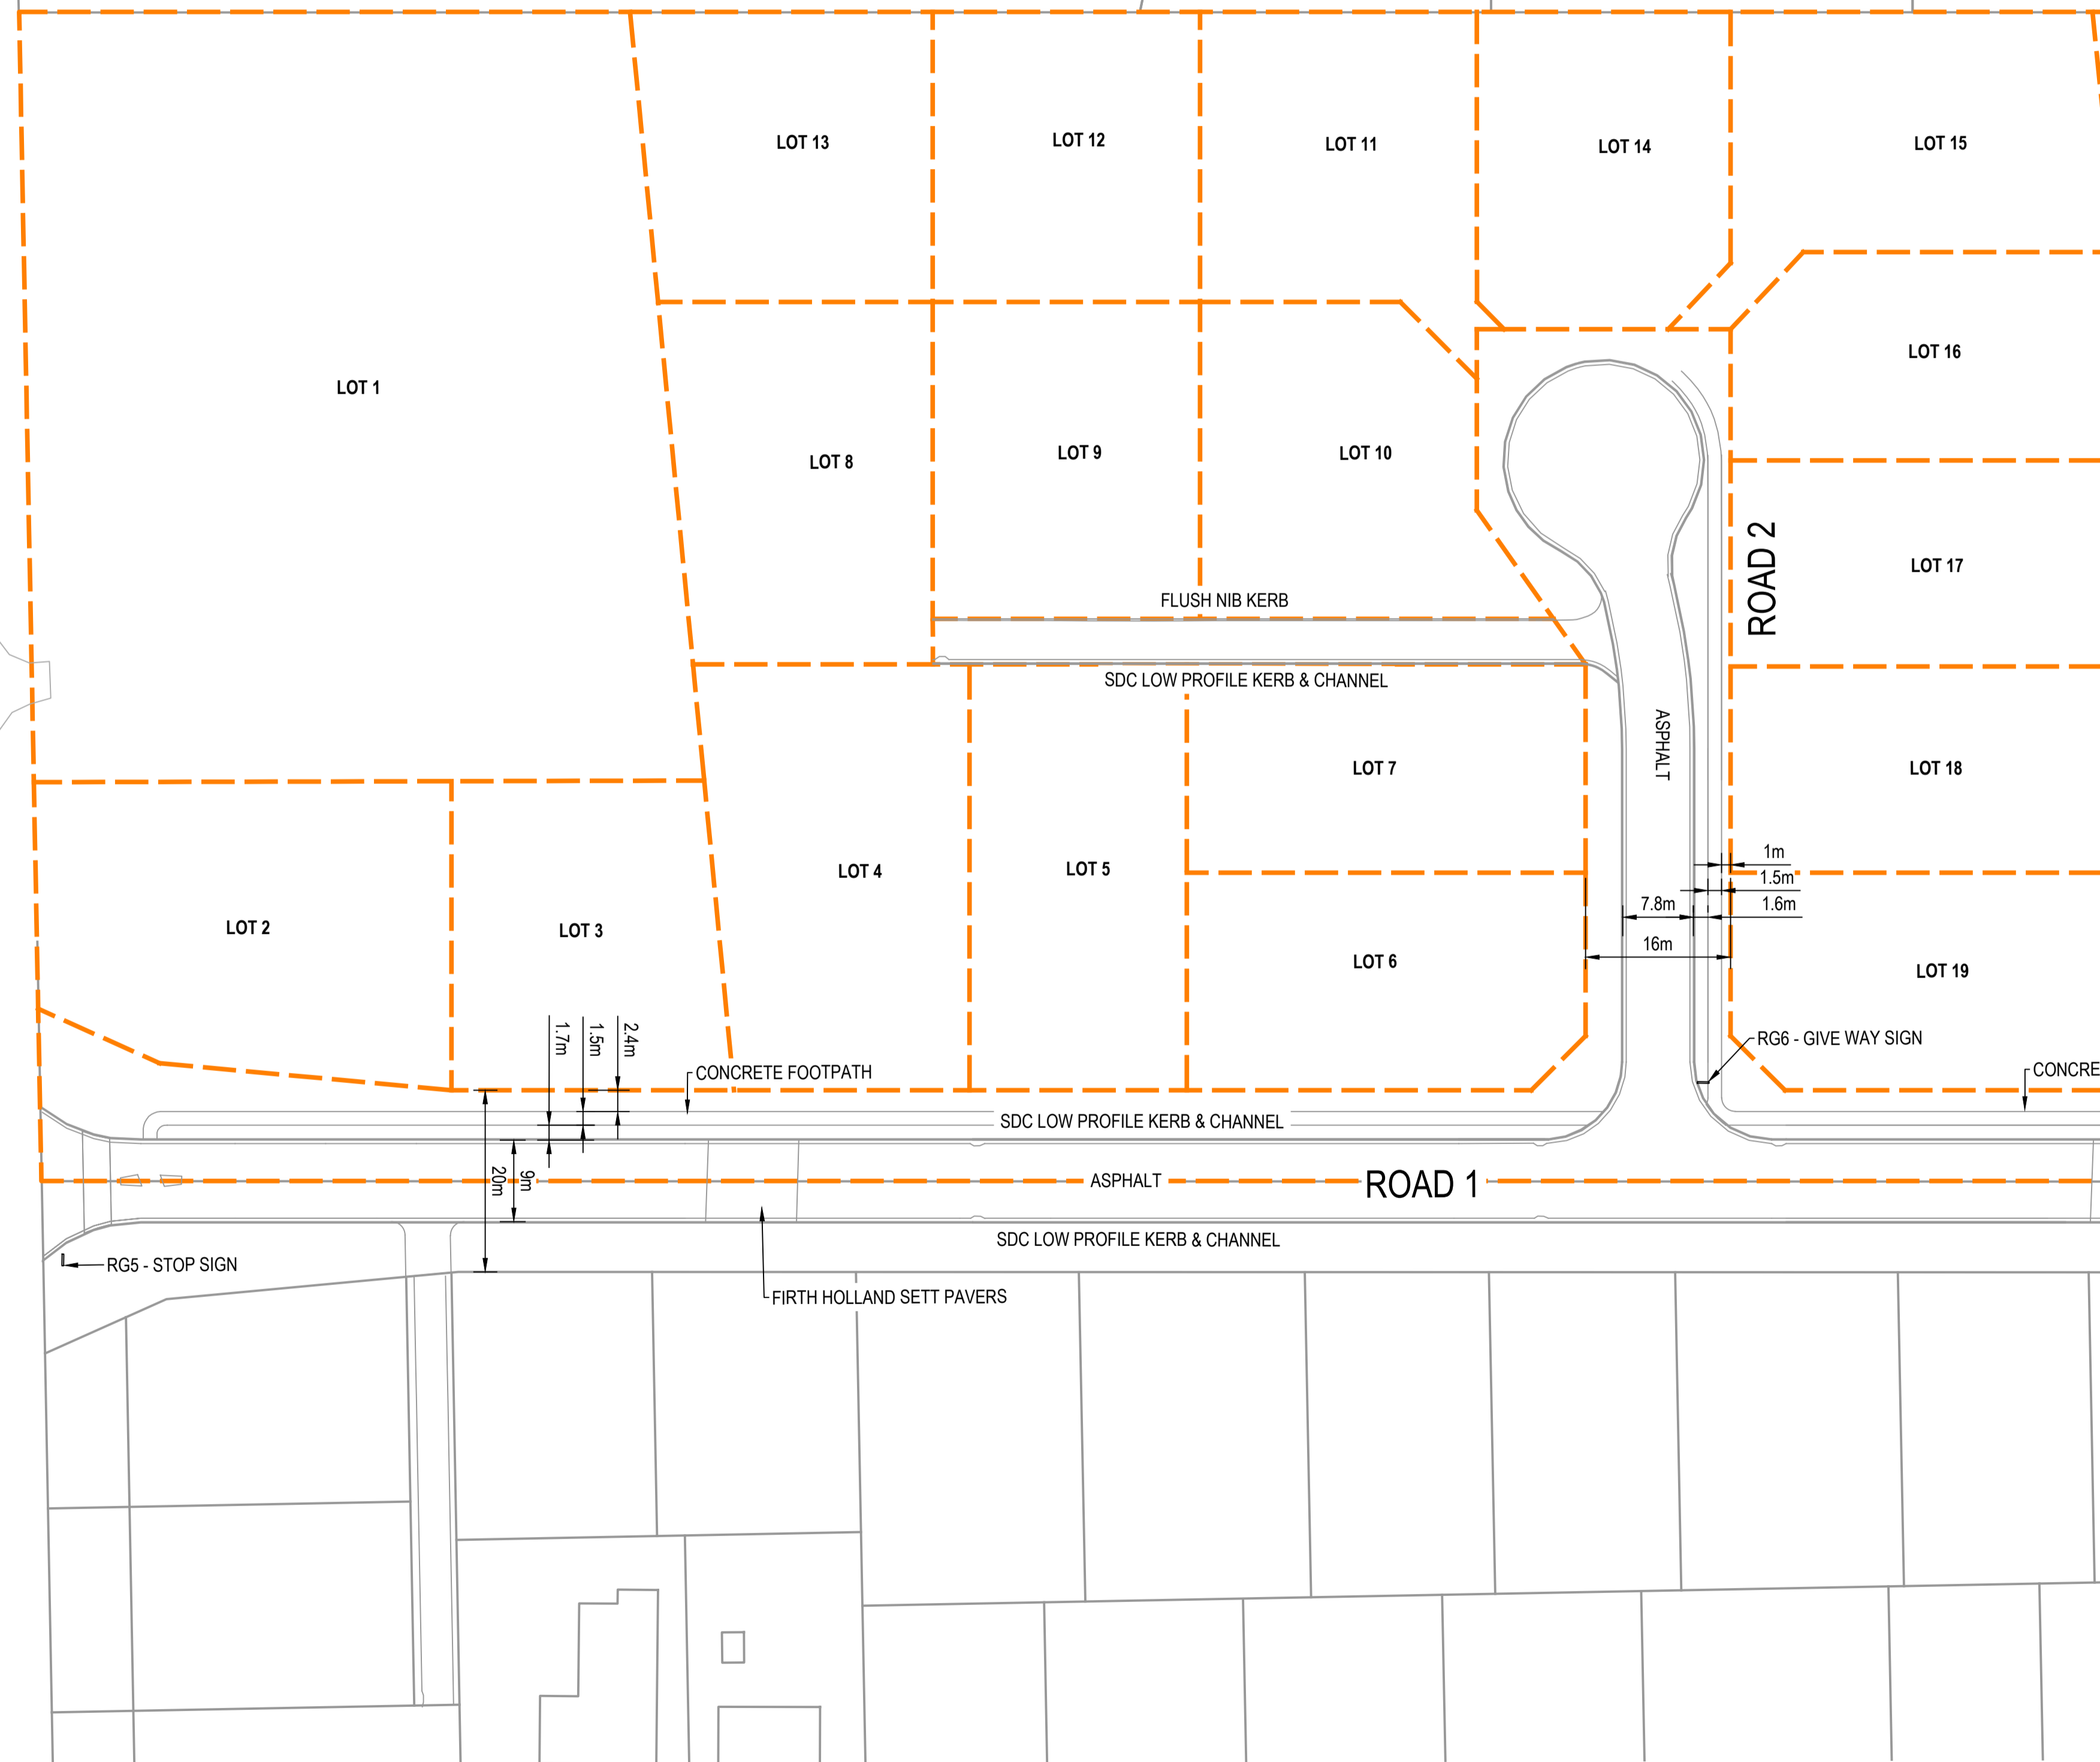

A	03-05-2022	AS BUILT	DM
REV	DATE	ISSUED FOR	BY

PROJECT
1920 TELEGRAPH ROAD
DARFIELD

CLIENT
EAST WEST DEVELOPMENTS LTD

TITLE
ROAD AS BUILTS
DRAWING 1 OF 2

REVIEWED BY: DM 03-05-2022

DESIGNED BY: BW

DRAWN BY: BW

SCALE: 1:500 (A1) JOB NO.: 2110455

DRAWING NO.: RD_AB.1 REV.: A

AS BUILT

SCALE 1:500 (A1) 0 10 20 30 40 50m


THIS IS A COLOUR DRAWING



NOTES:
THIS DRAWING IS THE PROPERTY AND COPYRIGHT OF KIRK ROBERTS CONSULTING ENGINEERS LTD AND SHALL NOT BE COPIED REPRODUCED OR COMMUNICATED TO A THIRD PARTY WITHOUT WRITTEN CONSENT (C) 2017.

THIS DRAWING TO BE READ IN CONJUNCTION WITH THE LATEST DRAWINGS AND SPECIFICATIONS FROM ALL OTHER DISCIPLINES. PROJECT MANAGER TO BE NOTIFIED OF ANY VARIATION BETWEEN SITE DIMENSIONS AND THOSE ON DRAWINGS ALL DIMENSIONS ARE SHOWN IN METRES UNLESS OTHERWISE STATED.

THIS PLAN IS FOR AS BUILT PURPOSES ONLY.

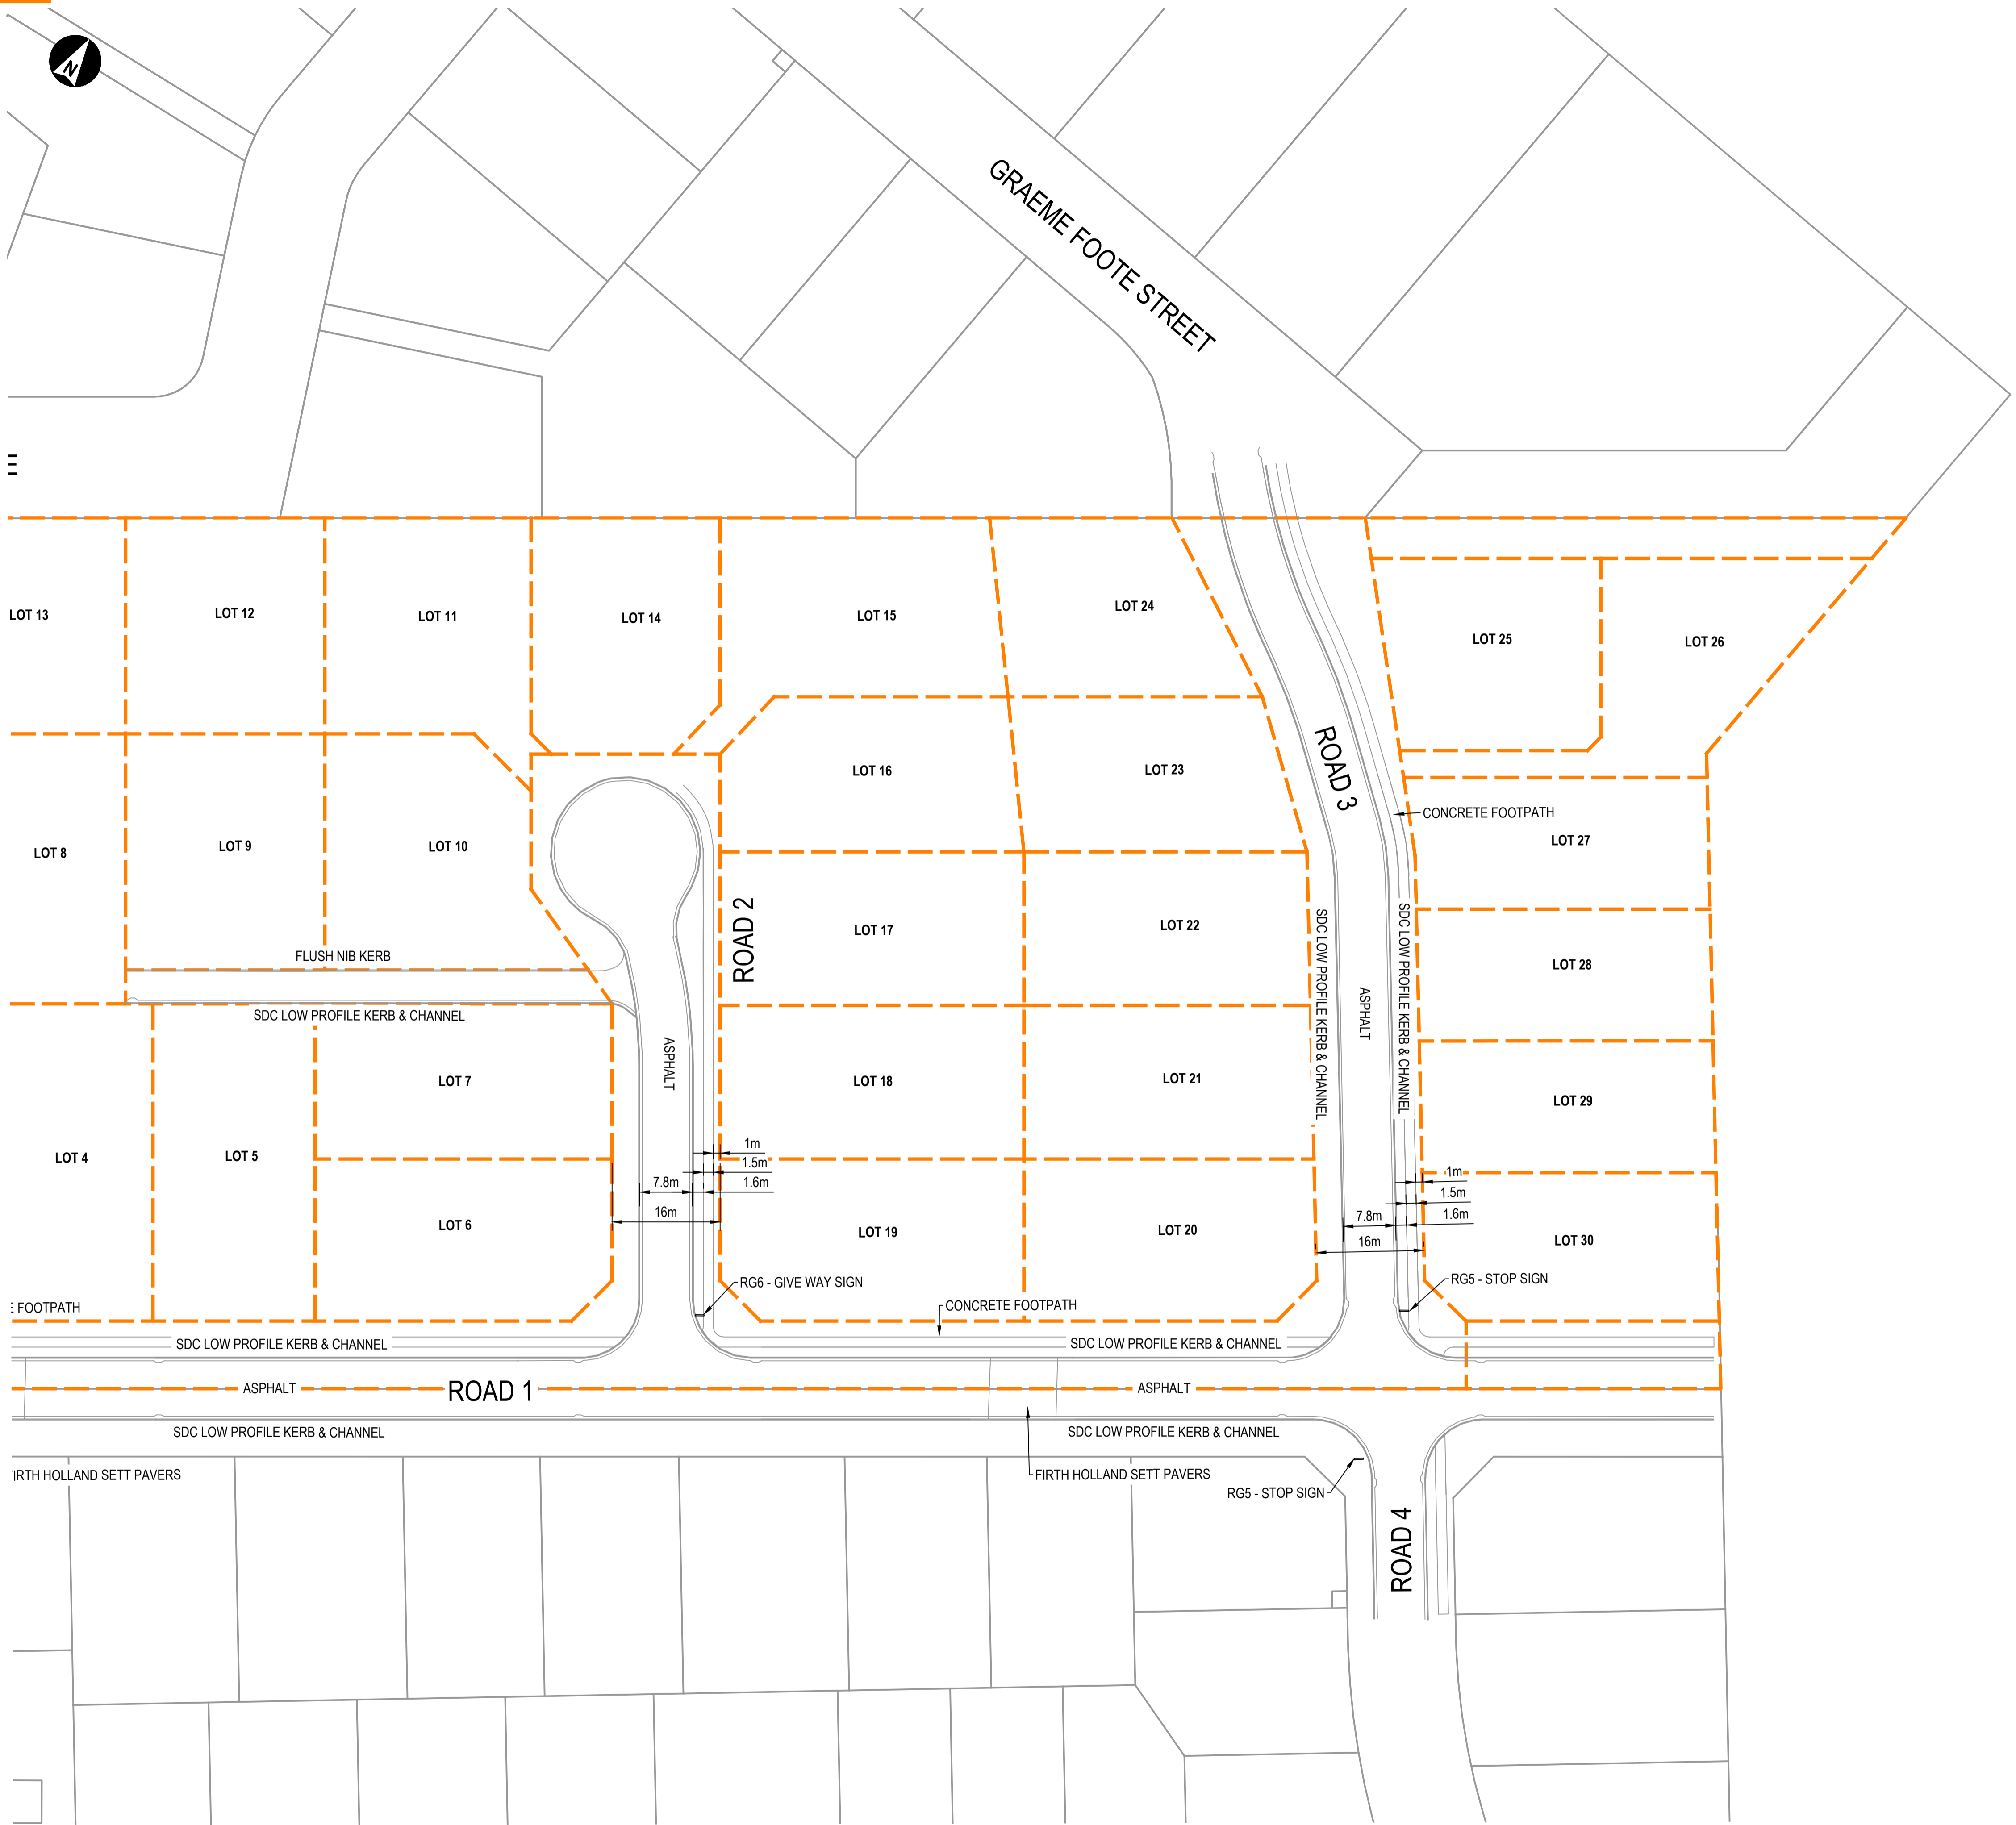

A	03-05-2022	AS BUILT	DM
REV	DATE	ISSUED FOR	BY

PROJECT
1920 TELEGRAPH ROAD
DARFIELD

CLIENT
EAST WEST DEVELOPMENTS LTD

TITLE
ROAD AS BUILTS
DRAWING 2 OF 2

REVIEWED BY: DM 03-05-2022


DESIGNED BY: BW

DRAWN BY: BW

SCALE: 1:500 (A1) JOB NO.: 2110455

DRAWING NO.: RD_AB.2 REV.: A

AS BUILT

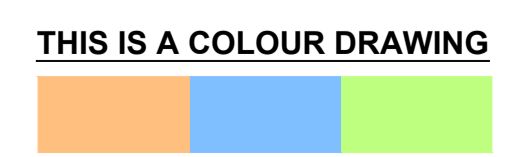


Cadd File: Z:\PROJ_2021\10455-1920_TELEGRAPH_ROADS_DELIVERY\8_DRAFT\CIVIL\1920-TELEGRAPH-ROADS-ROADING_AB.DWG Plot Date: 31/03/2022 3:57:54 pm Name: Ben Williams Xrefs:



NOTES:
THIS DRAWING IS THE PROPERTY AND COPYRIGHT OF KIRK ROBERTS CONSULTING ENGINEERS LTD AND SHALL NOT BE COPIED REPRODUCED OR COMMUNICATED TO A THIRD PARTY WITHOUT WRITTEN CONSENT (C) 2017.

THIS DRAWING TO BE READ IN CONJUNCTION WITH THE LATEST DRAWINGS AND SPECIFICATIONS FROM ALL OTHER DISCIPLINES. PROJECT MANAGER TO BE NOTIFIED OF ANY VARIATION BETWEEN SITE DIMENSIONS AND THOSE ON DRAWINGS ALL DIMENSIONS ARE SHOWN IN METRES UNLESS OTHERWISE STATED.

THIS PLAN IS FOR AS BUILT PURPOSES ONLY.

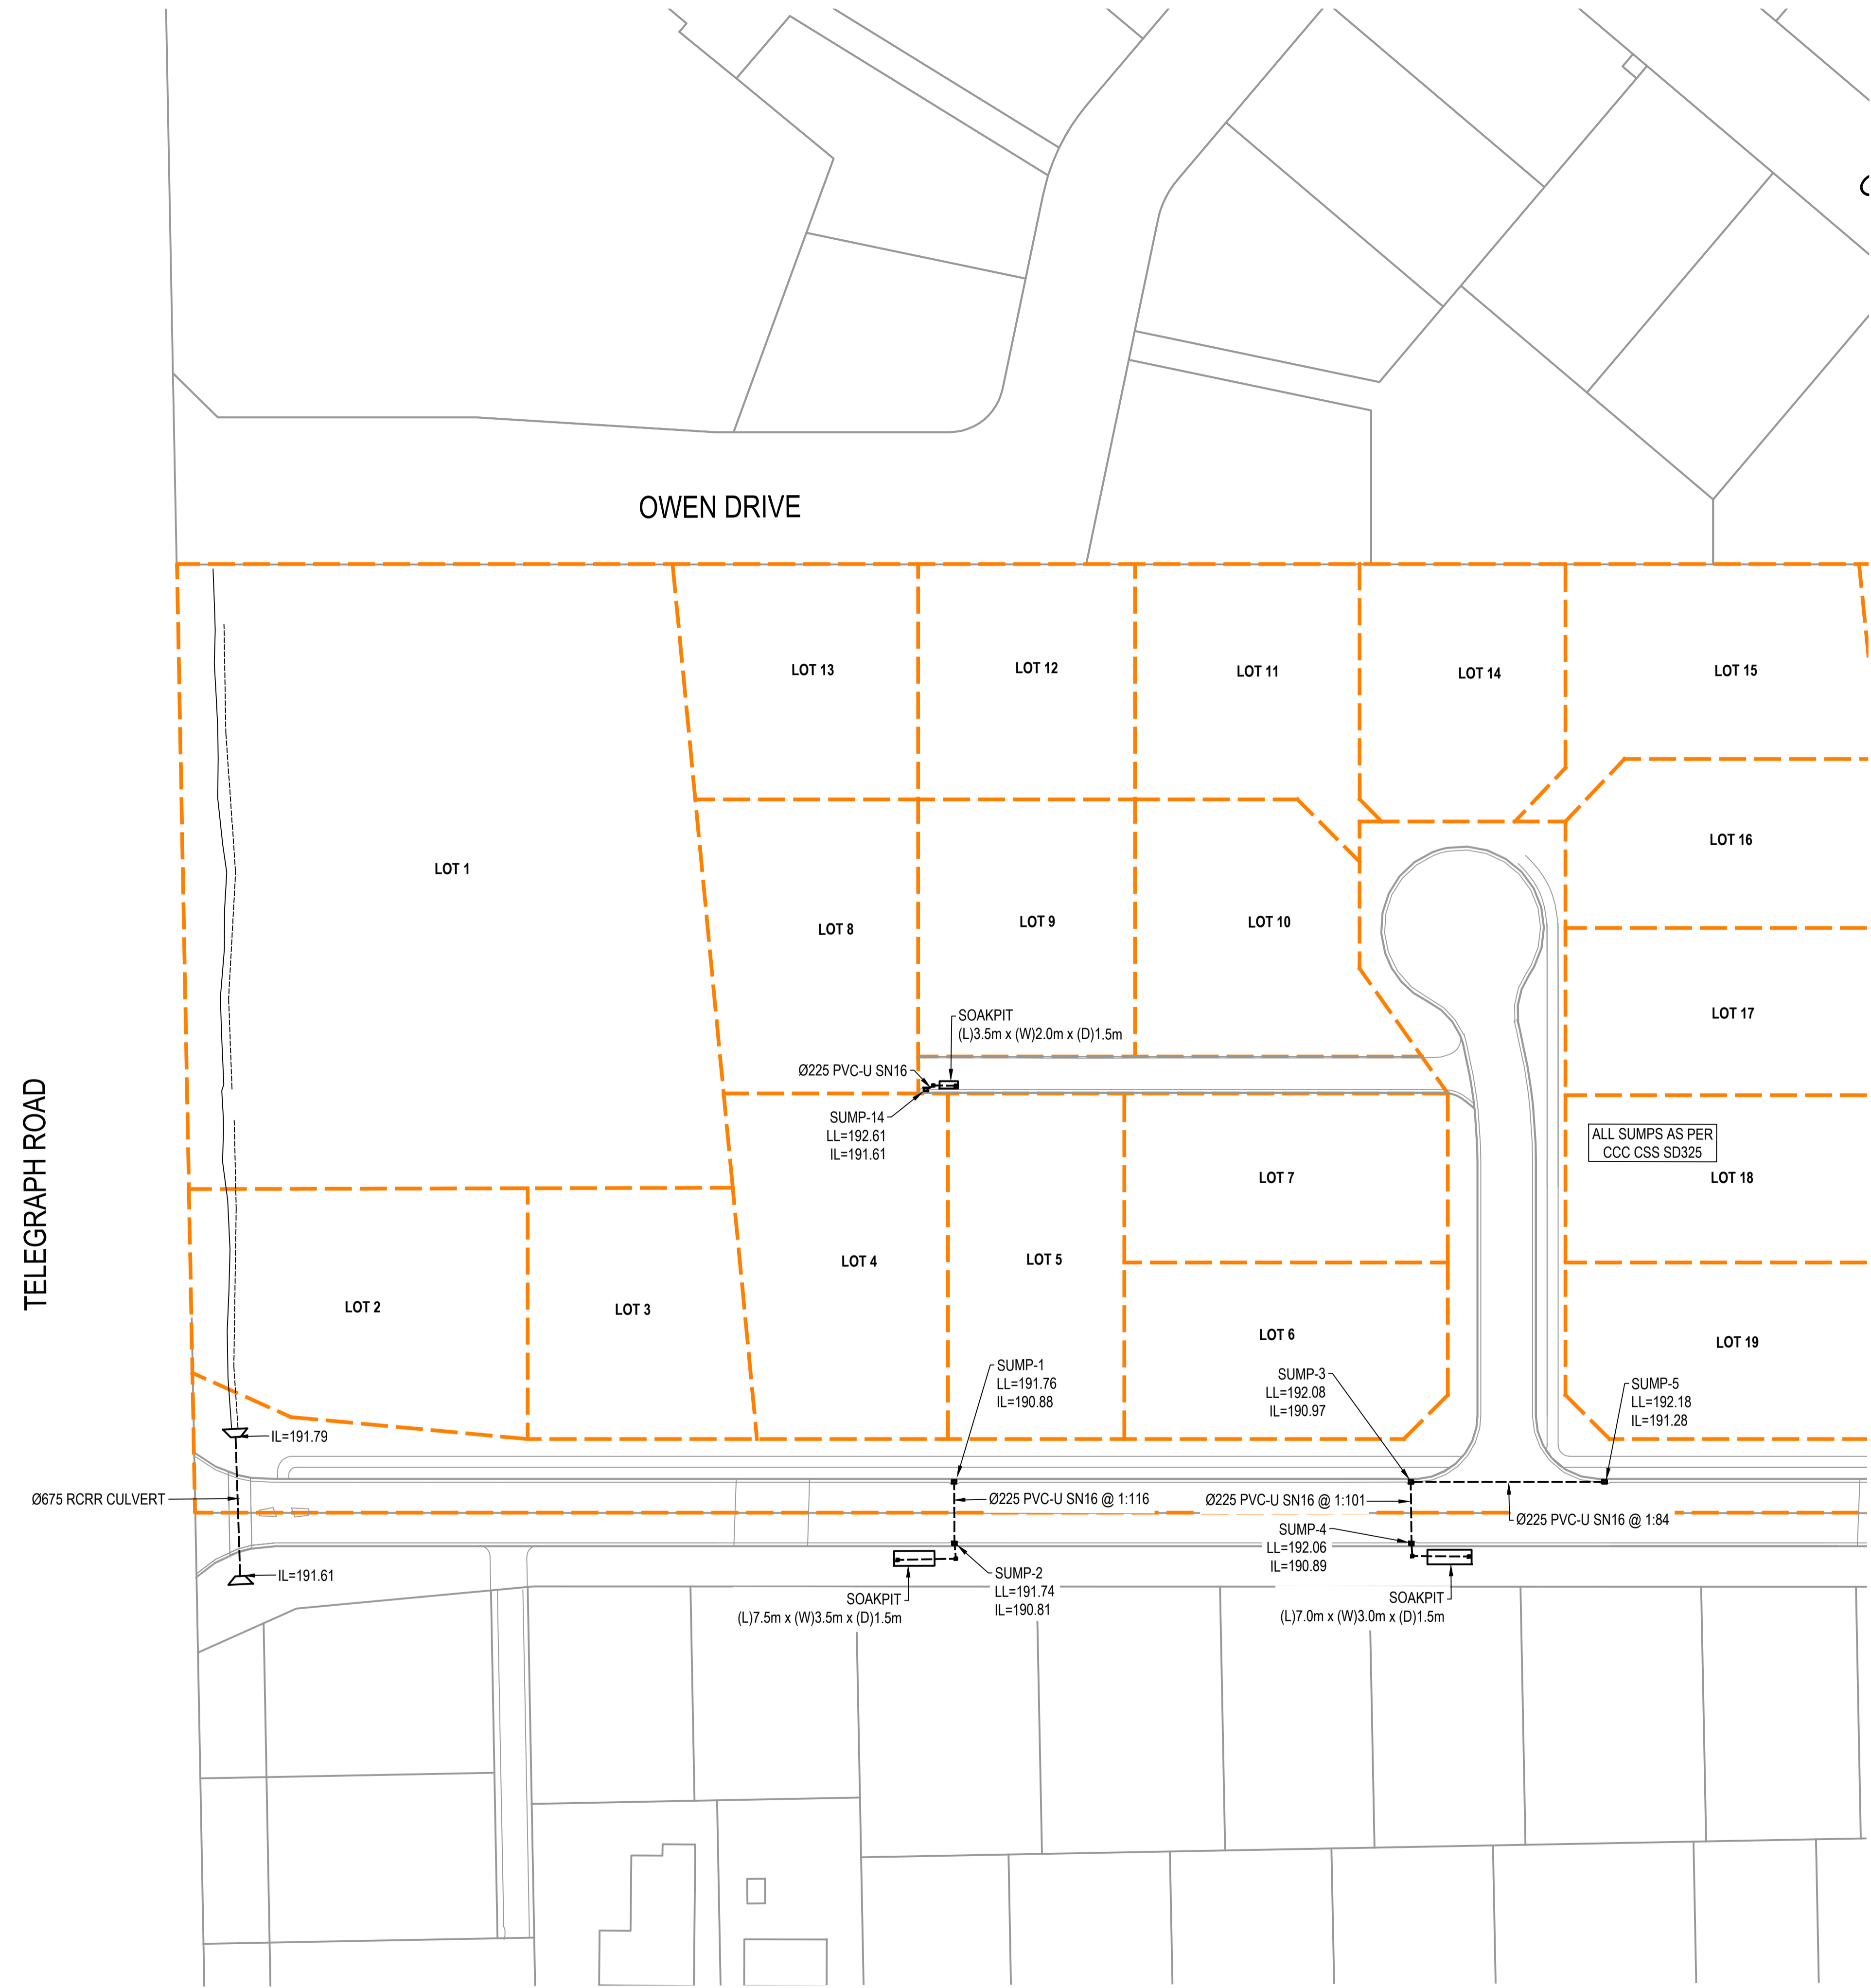

A	03-05-2022 AS BUILT	DM
REV	DATE	ISSUED FOR
		BY

PROJECT
1920 TELEGRAPH ROAD
DARFIELD

CLIENT
EAST WEST DEVELOPMENTS LTD

TITLE
STORMWATER AS BUILTS
DRAWING 1 OF 2

REVIEWED BY: DM 03-05-2022

DESIGNED BY: BW



DRAWN BY: BW

SCALE: 1:500 (A1) JOB NO.: 2110455

DRAWING NO.: SW_AB.1 REV.: A

AS BUILT


SCALE 1:500 (A1) 0 10 20 30 40 50m

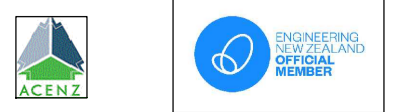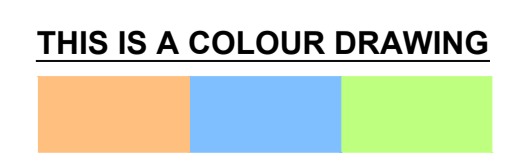

NOTES:
THIS DRAWING IS THE PROPERTY AND COPYRIGHT OF KIRK ROBERTS CONSULTING ENGINEERS LTD AND SHALL NOT BE COPIED REPRODUCED OR COMMUNICATED TO A THIRD PARTY WITHOUT WRITTEN CONSENT (C) 2017.

THIS DRAWING TO BE READ IN CONJUNCTION WITH THE LATEST DRAWINGS AND SPECIFICATIONS FROM ALL OTHER DISCIPLINES. PROJECT MANAGER TO BE NOTIFIED OF ANY VARIATION BETWEEN SITE DIMENSIONS AND THOSE ON DRAWINGS ALL DIMENSIONS ARE SHOWN IN METRES UNLESS OTHERWISE STATED.

THIS PLAN IS FOR AS BUILT PURPOSES ONLY.

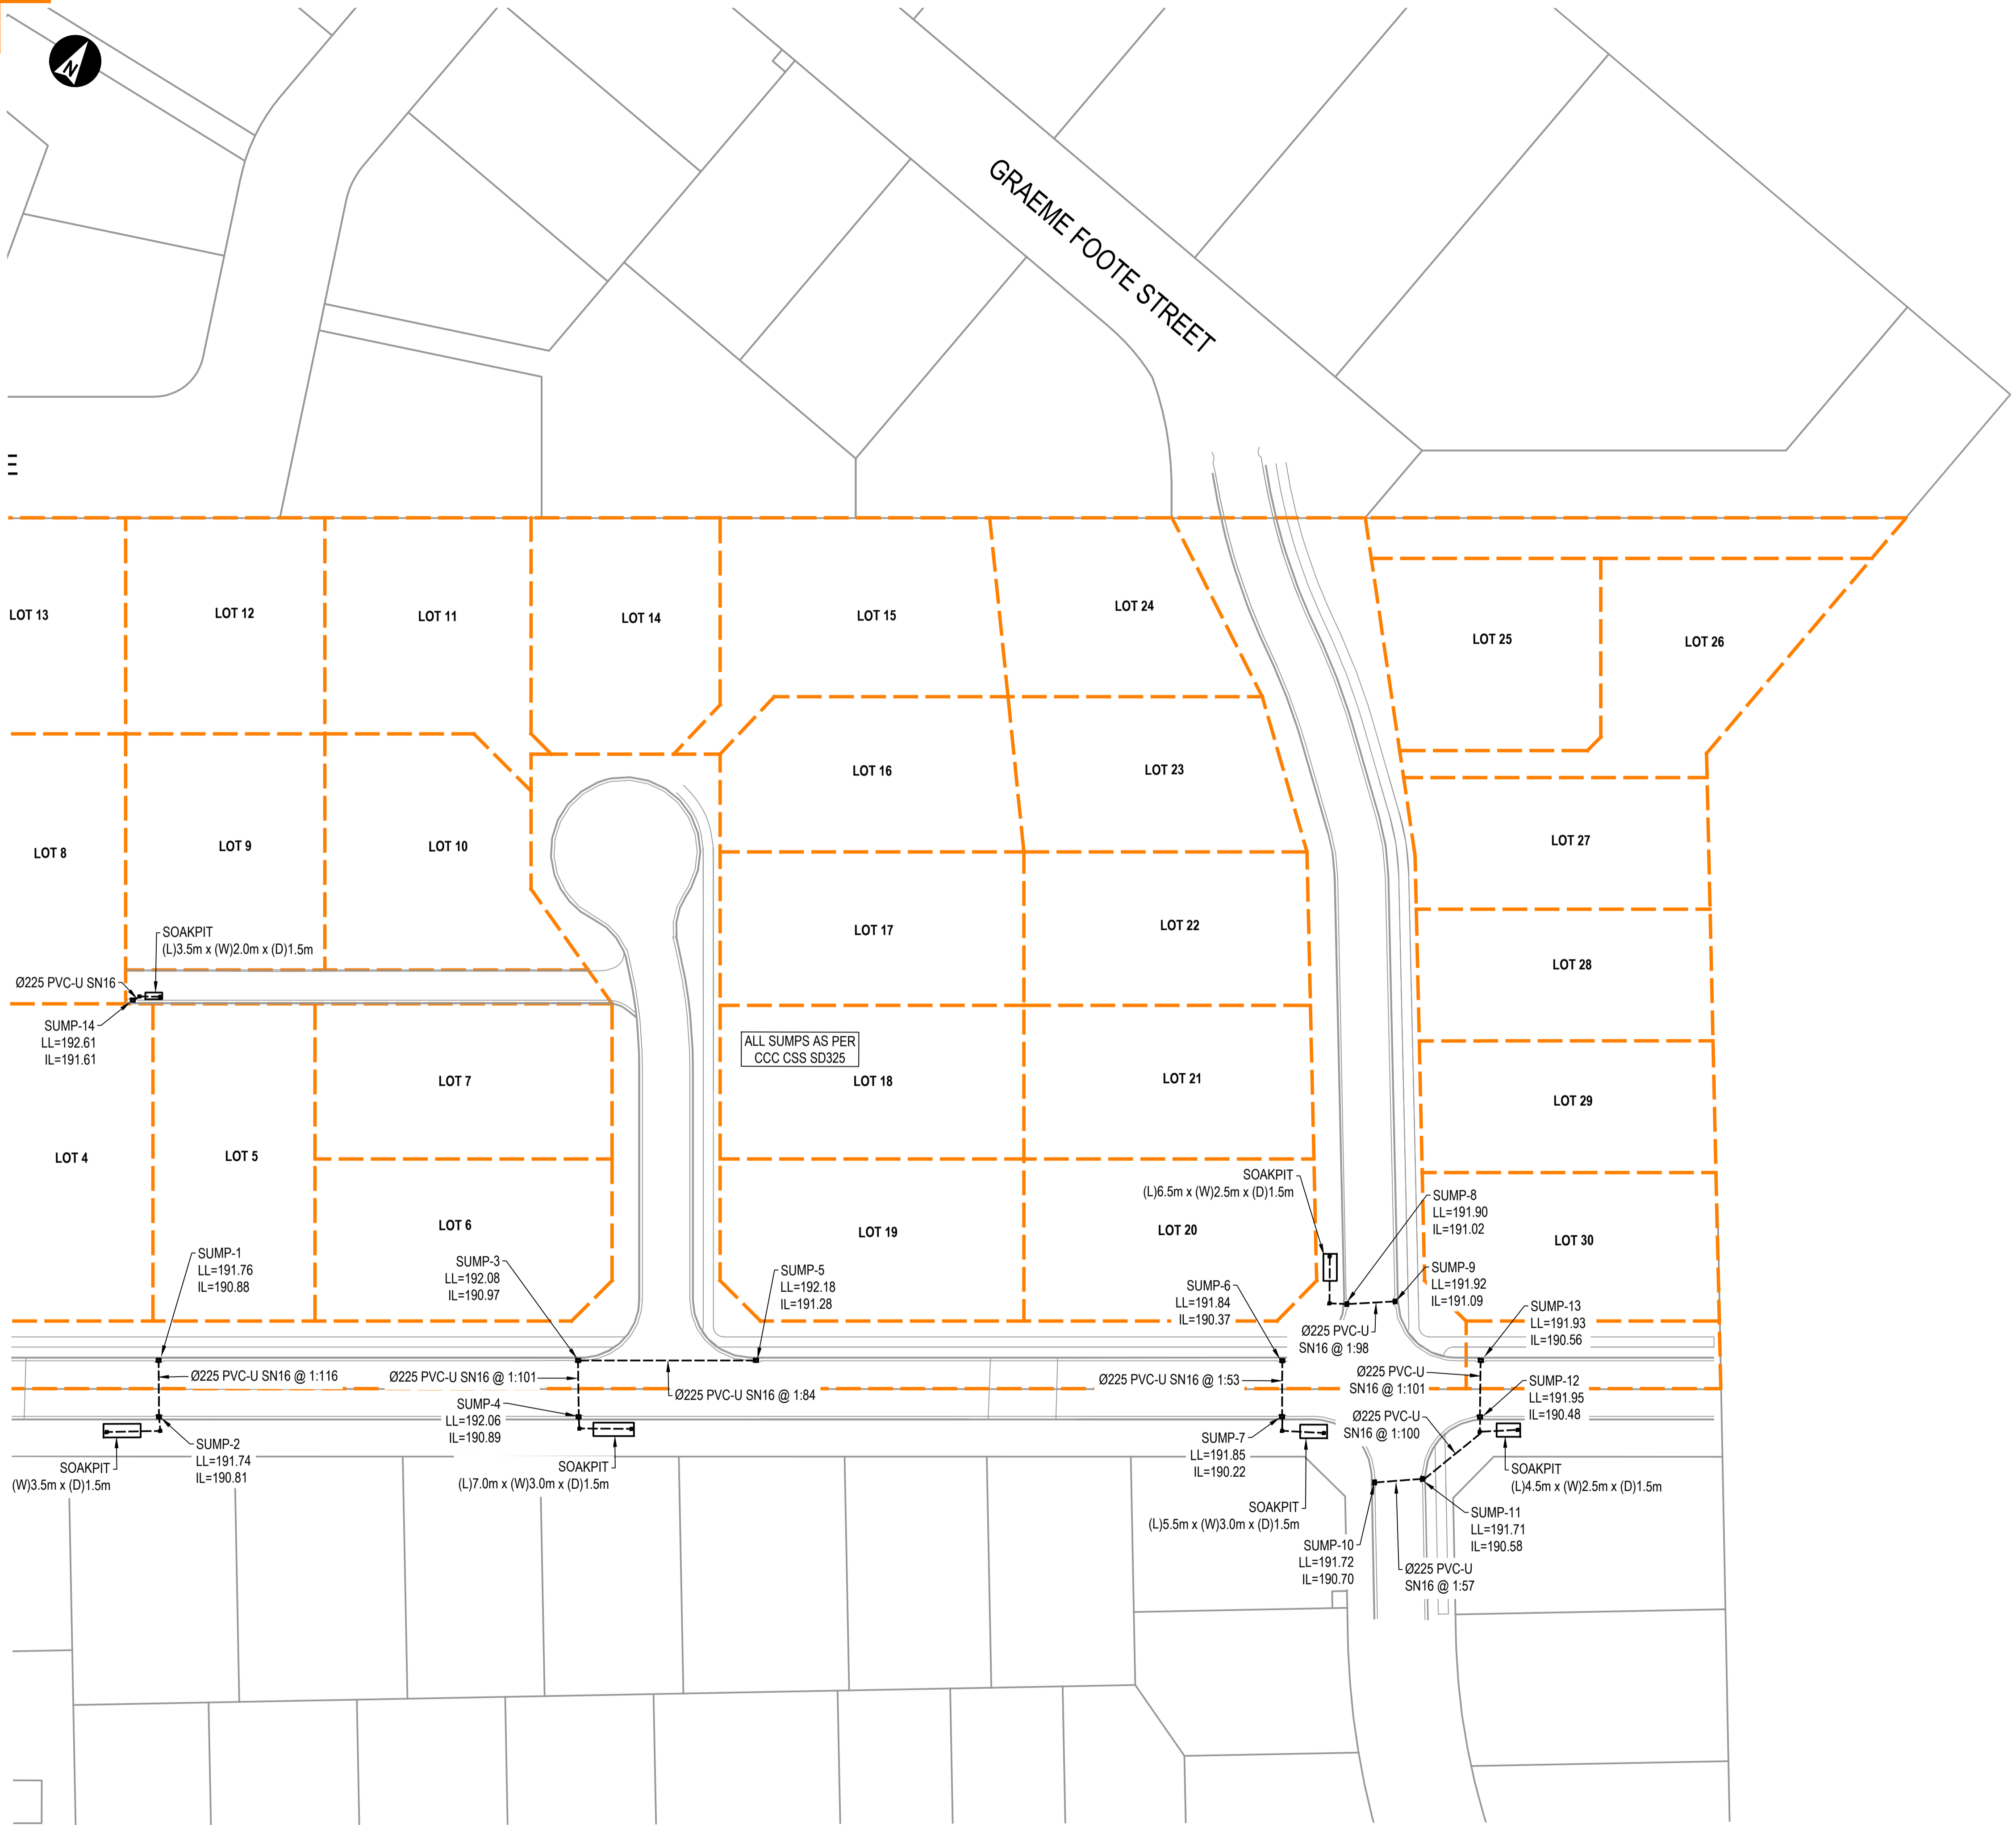

A	03-05-2022 AS BUILT	DM
REV	DATE ISSUED FOR	BY

PROJECT
1920 TELEGRAPH ROAD
DARFIELD

CLIENT
EAST WEST DEVELOPMENTS LTD

TITLE
STORMWATER AS BUILTS
DRAWING 2 OF 2

REVIEWED BY: DM 03-05-2022

DESIGNED BY: BW


DRAWN BY: BW

SCALE: 1:500 (A1) JOB NO.: 2110455

DRAWING NO.: SW_AB.2 REV.: A

AS BUILT

THIS IS A COLOUR DRAWING

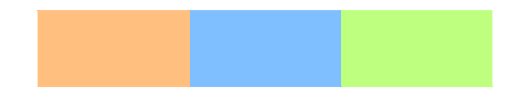


C:\proj\2110455\1920_TelegraphRd\ROADS_DELIVERY\8_DRAFT\DWG\1920_455_SV_AB_DWG.dwg
 Plot Date: 5/10/2022 3:59:30 pm. Name: Ben Williams Xref:



NOTES:
THIS DRAWING IS THE PROPERTY AND COPYRIGHT OF KIRK ROBERTS CONSULTING ENGINEERS LTD AND SHALL NOT BE COPIED REPRODUCED OR COMMUNICATED TO A THIRD PARTY WITHOUT WRITTEN CONSENT (C) 2017.

THIS DRAWING TO BE READ IN CONJUNCTION WITH THE LATEST DRAWINGS AND SPECIFICATIONS FROM ALL OTHER DISCIPLINES. PROJECT MANAGER TO BE NOTIFIED OF ANY VARIATION BETWEEN SITE DIMENSIONS AND THOSE ON DRAWINGS ALL DIMENSIONS ARE SHOWN IN METRES UNLESS OTHERWISE STATED.

THIS PLAN IS FOR AS BUILT PURPOSES ONLY.

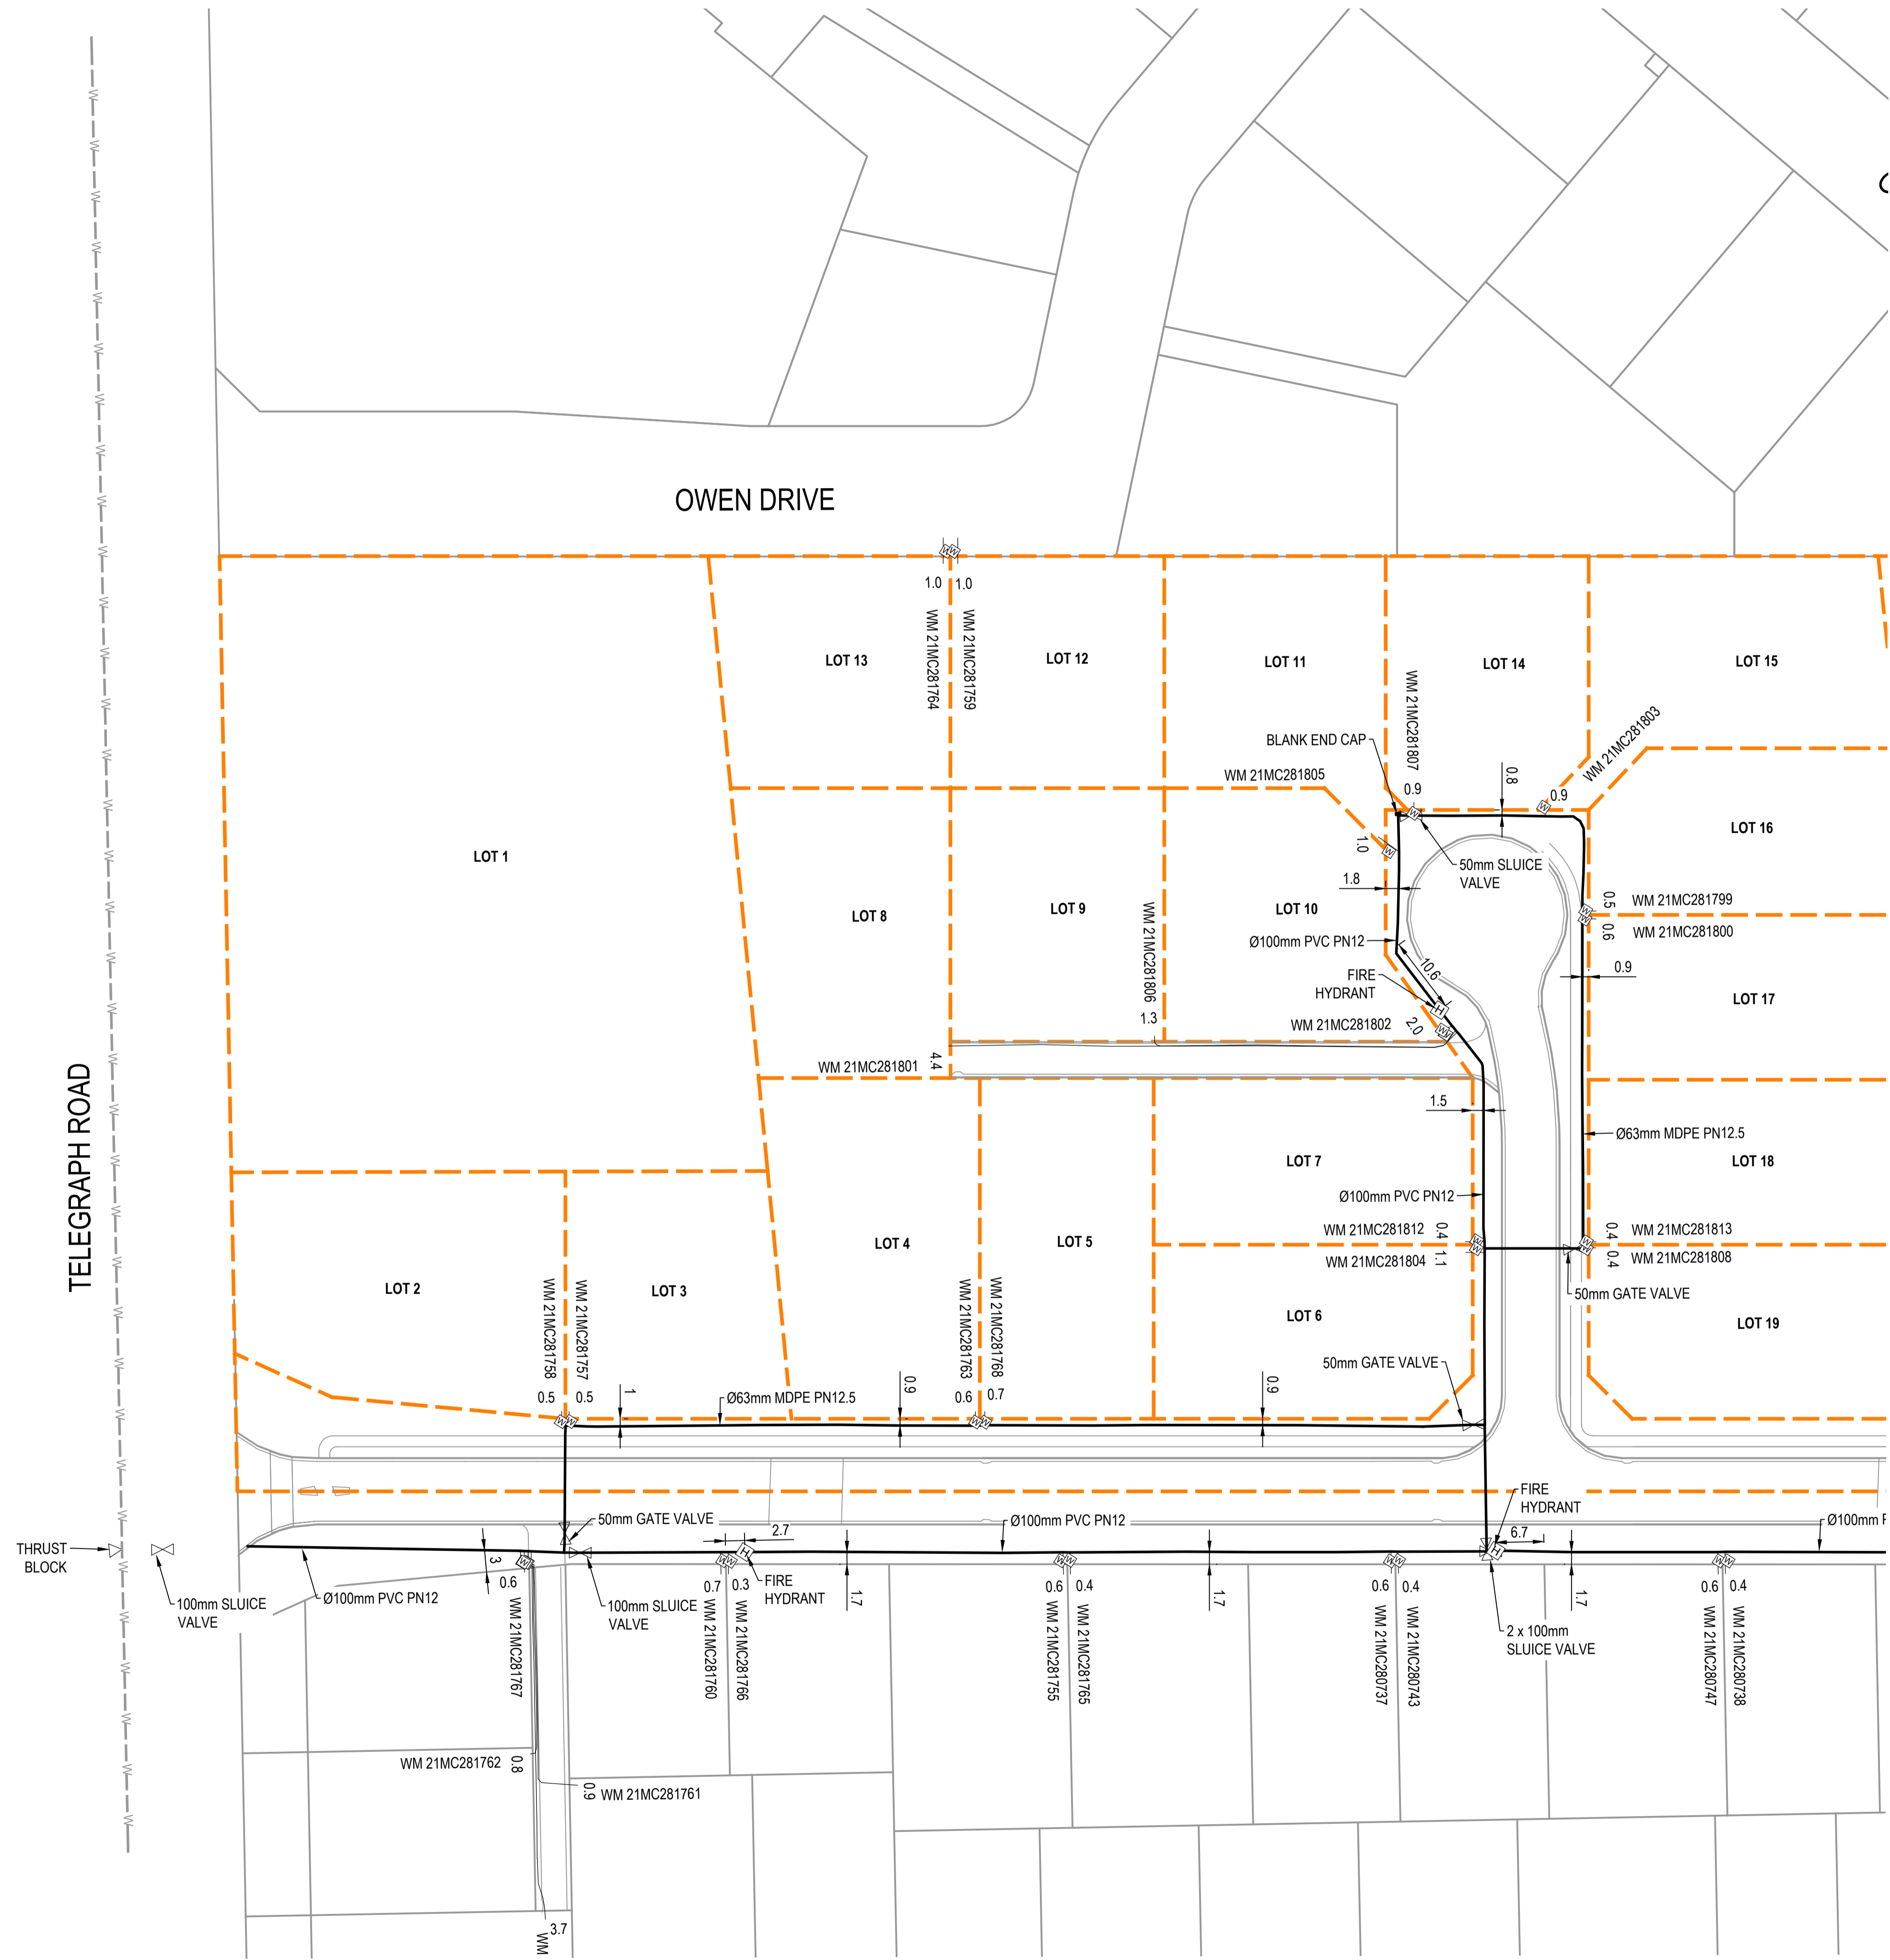

C:\proj\211045-1920-TELEGRAPH RD\DELIVERY\8_DRAFT\1011045-WS_AB.DWG - Plot Date: 5/10/2022 4:00:41 pm. Name: Ben Williams .xref

SCALE 1:500 (A1) 0 10 20 30 40 50m

THIS IS A COLOUR DRAWING

A	21-04-2022 AS BUILT	DM
REV	DATE ISSUED FOR	BY

PROJECT
1920 TELEGRAPH ROAD
DARFIELD

CLIENT
EAST WEST DEVELOPMENTS LTD

TITLE
WATER SUPPLY AS BUILTS
DRAWING 1 OF 2

REVIEWED BY: DM 21-04-2022

DESIGNED BY: BW

DRAWN BY: BW

SCALE 1:500 (A1) JOB NO. 2110455

DRAWING NO. REV.

WS_AB.1 A


AS BUILT



NOTES:
THIS DRAWING IS THE PROPERTY AND COPYRIGHT OF KIRK ROBERTS CONSULTING ENGINEERS LTD AND SHALL NOT BE COPIED REPRODUCED OR COMMUNICATED TO A THIRD PARTY WITHOUT WRITTEN CONSENT (C) 2017.

THIS DRAWING TO BE READ IN CONJUNCTION WITH THE LATEST DRAWINGS AND SPECIFICATIONS FROM ALL OTHER DISCIPLINES. PROJECT MANAGER TO BE NOTIFIED OF ANY VARIATION BETWEEN SITE DIMENSIONS AND THOSE ON DRAWINGS ALL DIMENSIONS ARE SHOWN IN METRES UNLESS OTHERWISE STATED.

THIS PLAN IS FOR AS BUILT PURPOSES ONLY.

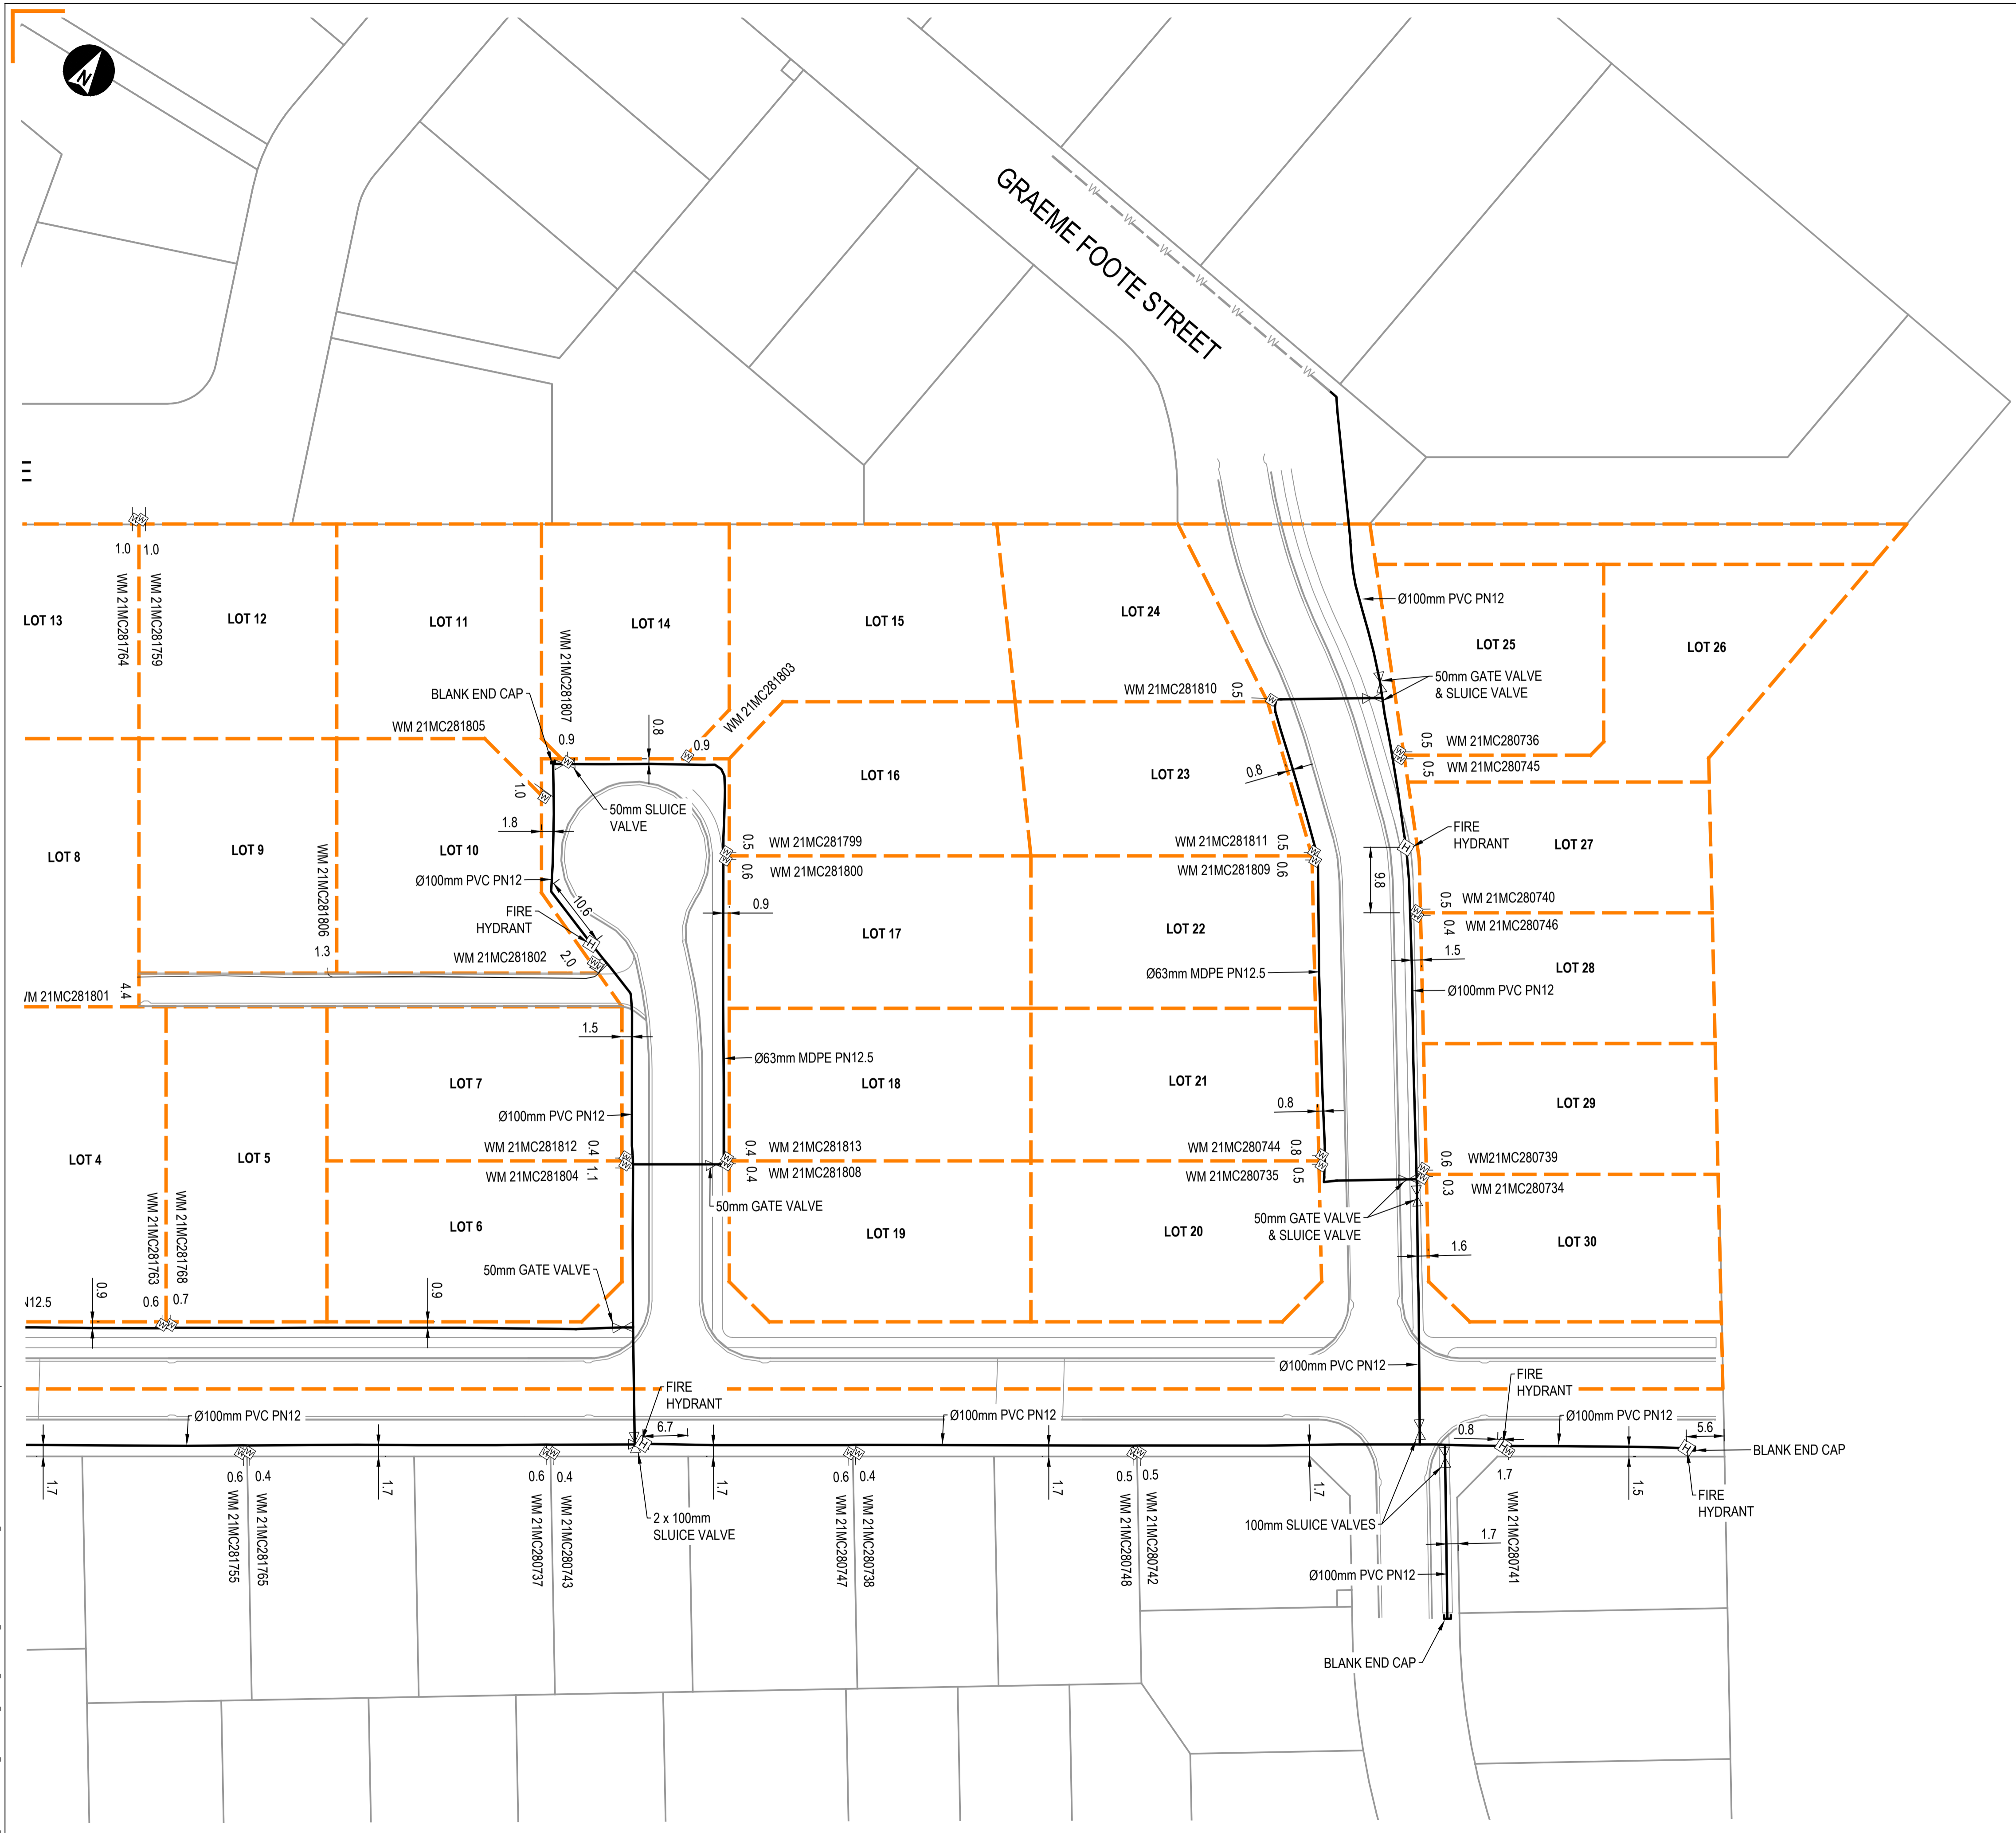

A	21-04-2022	AS BUILT	DM
REV	DATE	ISSUED FOR	BY

PROJECT
1920 TELEGRAPH ROAD
DARFIELD

CLIENT
EAST WEST DEVELOPMENTS LTD

TITLE
WATER SUPPLY AS BUILTS
DRAWING 2 OF 2

REVIEWED BY: DM 21-04-2022


DESIGNED BY: BW

DRAWN BY: BW


SCALE: 1:500 (A1) JOB NO.: 2110455

DRAWING NO.: WS_AB.2 REV.: A

AS BUILT

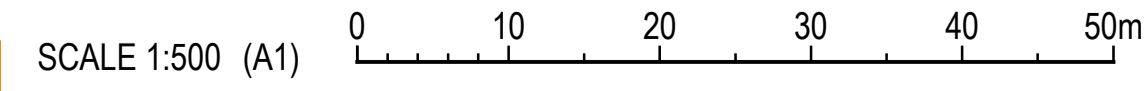

THIS IS A COLOUR DRAWING

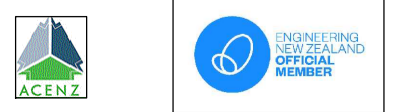


C:\p\proj\2021\10455-1920 TELEGRAPH RD\DELIVERY\8_DRAFT\10110455-WS_AB.DWG Rev: 05/10/2022 4:01:11 pm. Name: Ben Williams .xref



NOTES:
THIS DRAWING IS THE PROPERTY AND COPYRIGHT OF KIRK ROBERTS CONSULTING ENGINEERS LTD AND SHALL NOT BE COPIED REPRODUCED OR COMMUNICATED TO A THIRD PARTY WITHOUT WRITTEN CONSENT (C) 2017.

THIS DRAWING TO BE READ IN CONJUNCTION WITH THE LATEST DRAWINGS AND SPECIFICATIONS FROM ALL OTHER DISCIPLINES. PROJECT MANAGER TO BE NOTIFIED OF ANY VARIATION BETWEEN SITE DIMENSIONS AND THOSE ON DRAWINGS ALL DIMENSIONS ARE SHOWN IN METRES UNLESS OTHERWISE STATED.

THIS PLAN IS FOR AS BUILT PURPOSES ONLY.

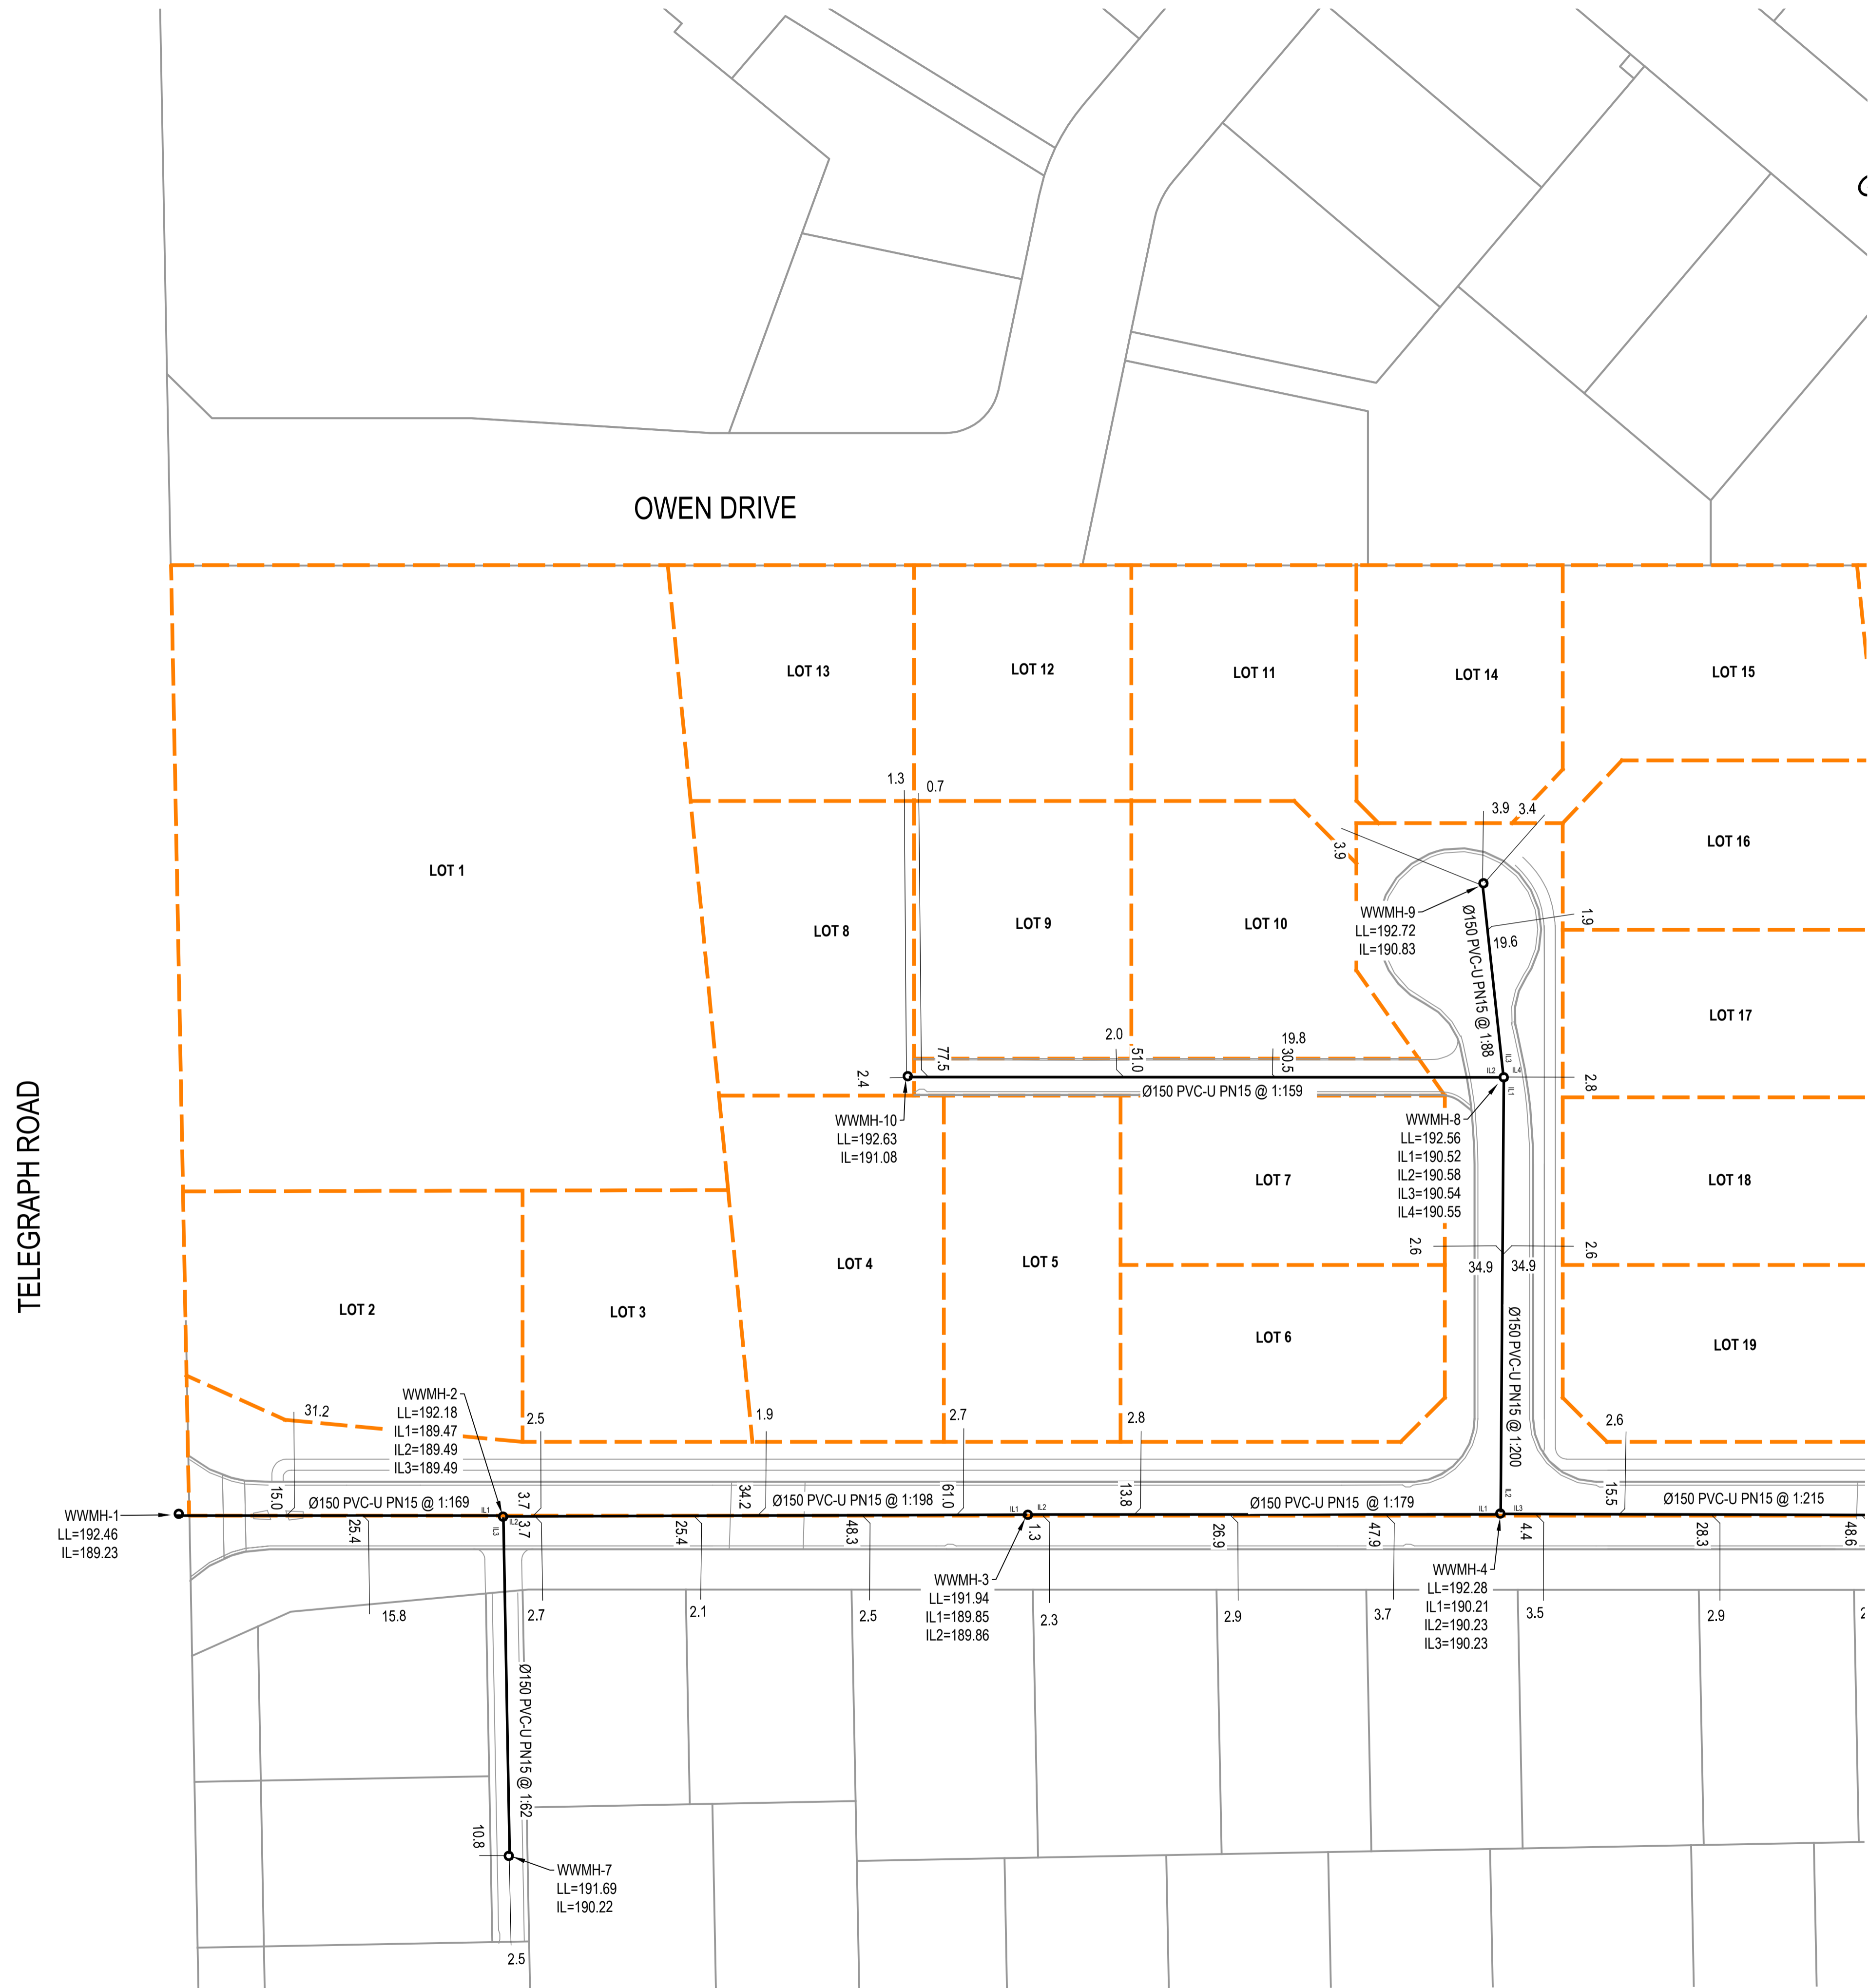

REV	DATE	ISSUED FOR	DM	BY
A	03-05-2022	AS BUILT		

PROJECT
**1920 TELEGRAPH ROAD
DARFIELD**

CLIENT
EAST WEST DEVELOPMENTS LTD

TITLE
**WASTEWATER AS BUILT
DRAWING 1 OF 2**

REVIEWED BY: DM 03-05-2022

DESIGNED BY: BW

DRAWN BY: BW

SCALE: 1:500 (A1) JOB NO.: 2110455

DRAWING NO.: WW_AB.1 REV: A

AS BUILT

THIS IS A COLOUR DRAWING




SCALE 1:500 (A1) 0 10 20 30 40 50m

Cadd File: Z:\PROJ_2021\1045-1920 TELEGRAPH RD\ROADS_DELIVERY8_DRAFT\DWG\1920-1945-WW_AB.DWG Plot Date: 5/10/2022 4:02:13 pm Name: Ben Williams Xrefs:

NOTES:
THIS DRAWING IS THE PROPERTY AND COPYRIGHT OF KIRK ROBERTS CONSULTING ENGINEERS LTD AND SHALL NOT BE COPIED REPRODUCED OR COMMUNICATED TO A THIRD PARTY WITHOUT WRITTEN CONSENT (C) 2017.

THIS DRAWING TO BE READ IN CONJUNCTION WITH THE LATEST DRAWINGS AND SPECIFICATIONS FROM ALL OTHER DISCIPLINES. PROJECT MANAGER TO BE NOTIFIED OF ANY VARIATION BETWEEN SITE DIMENSIONS AND THOSE ON DRAWINGS ALL DIMENSIONS ARE SHOWN IN METRES UNLESS OTHERWISE STATED.

THIS PLAN IS FOR AS BUILT PURPOSES ONLY.

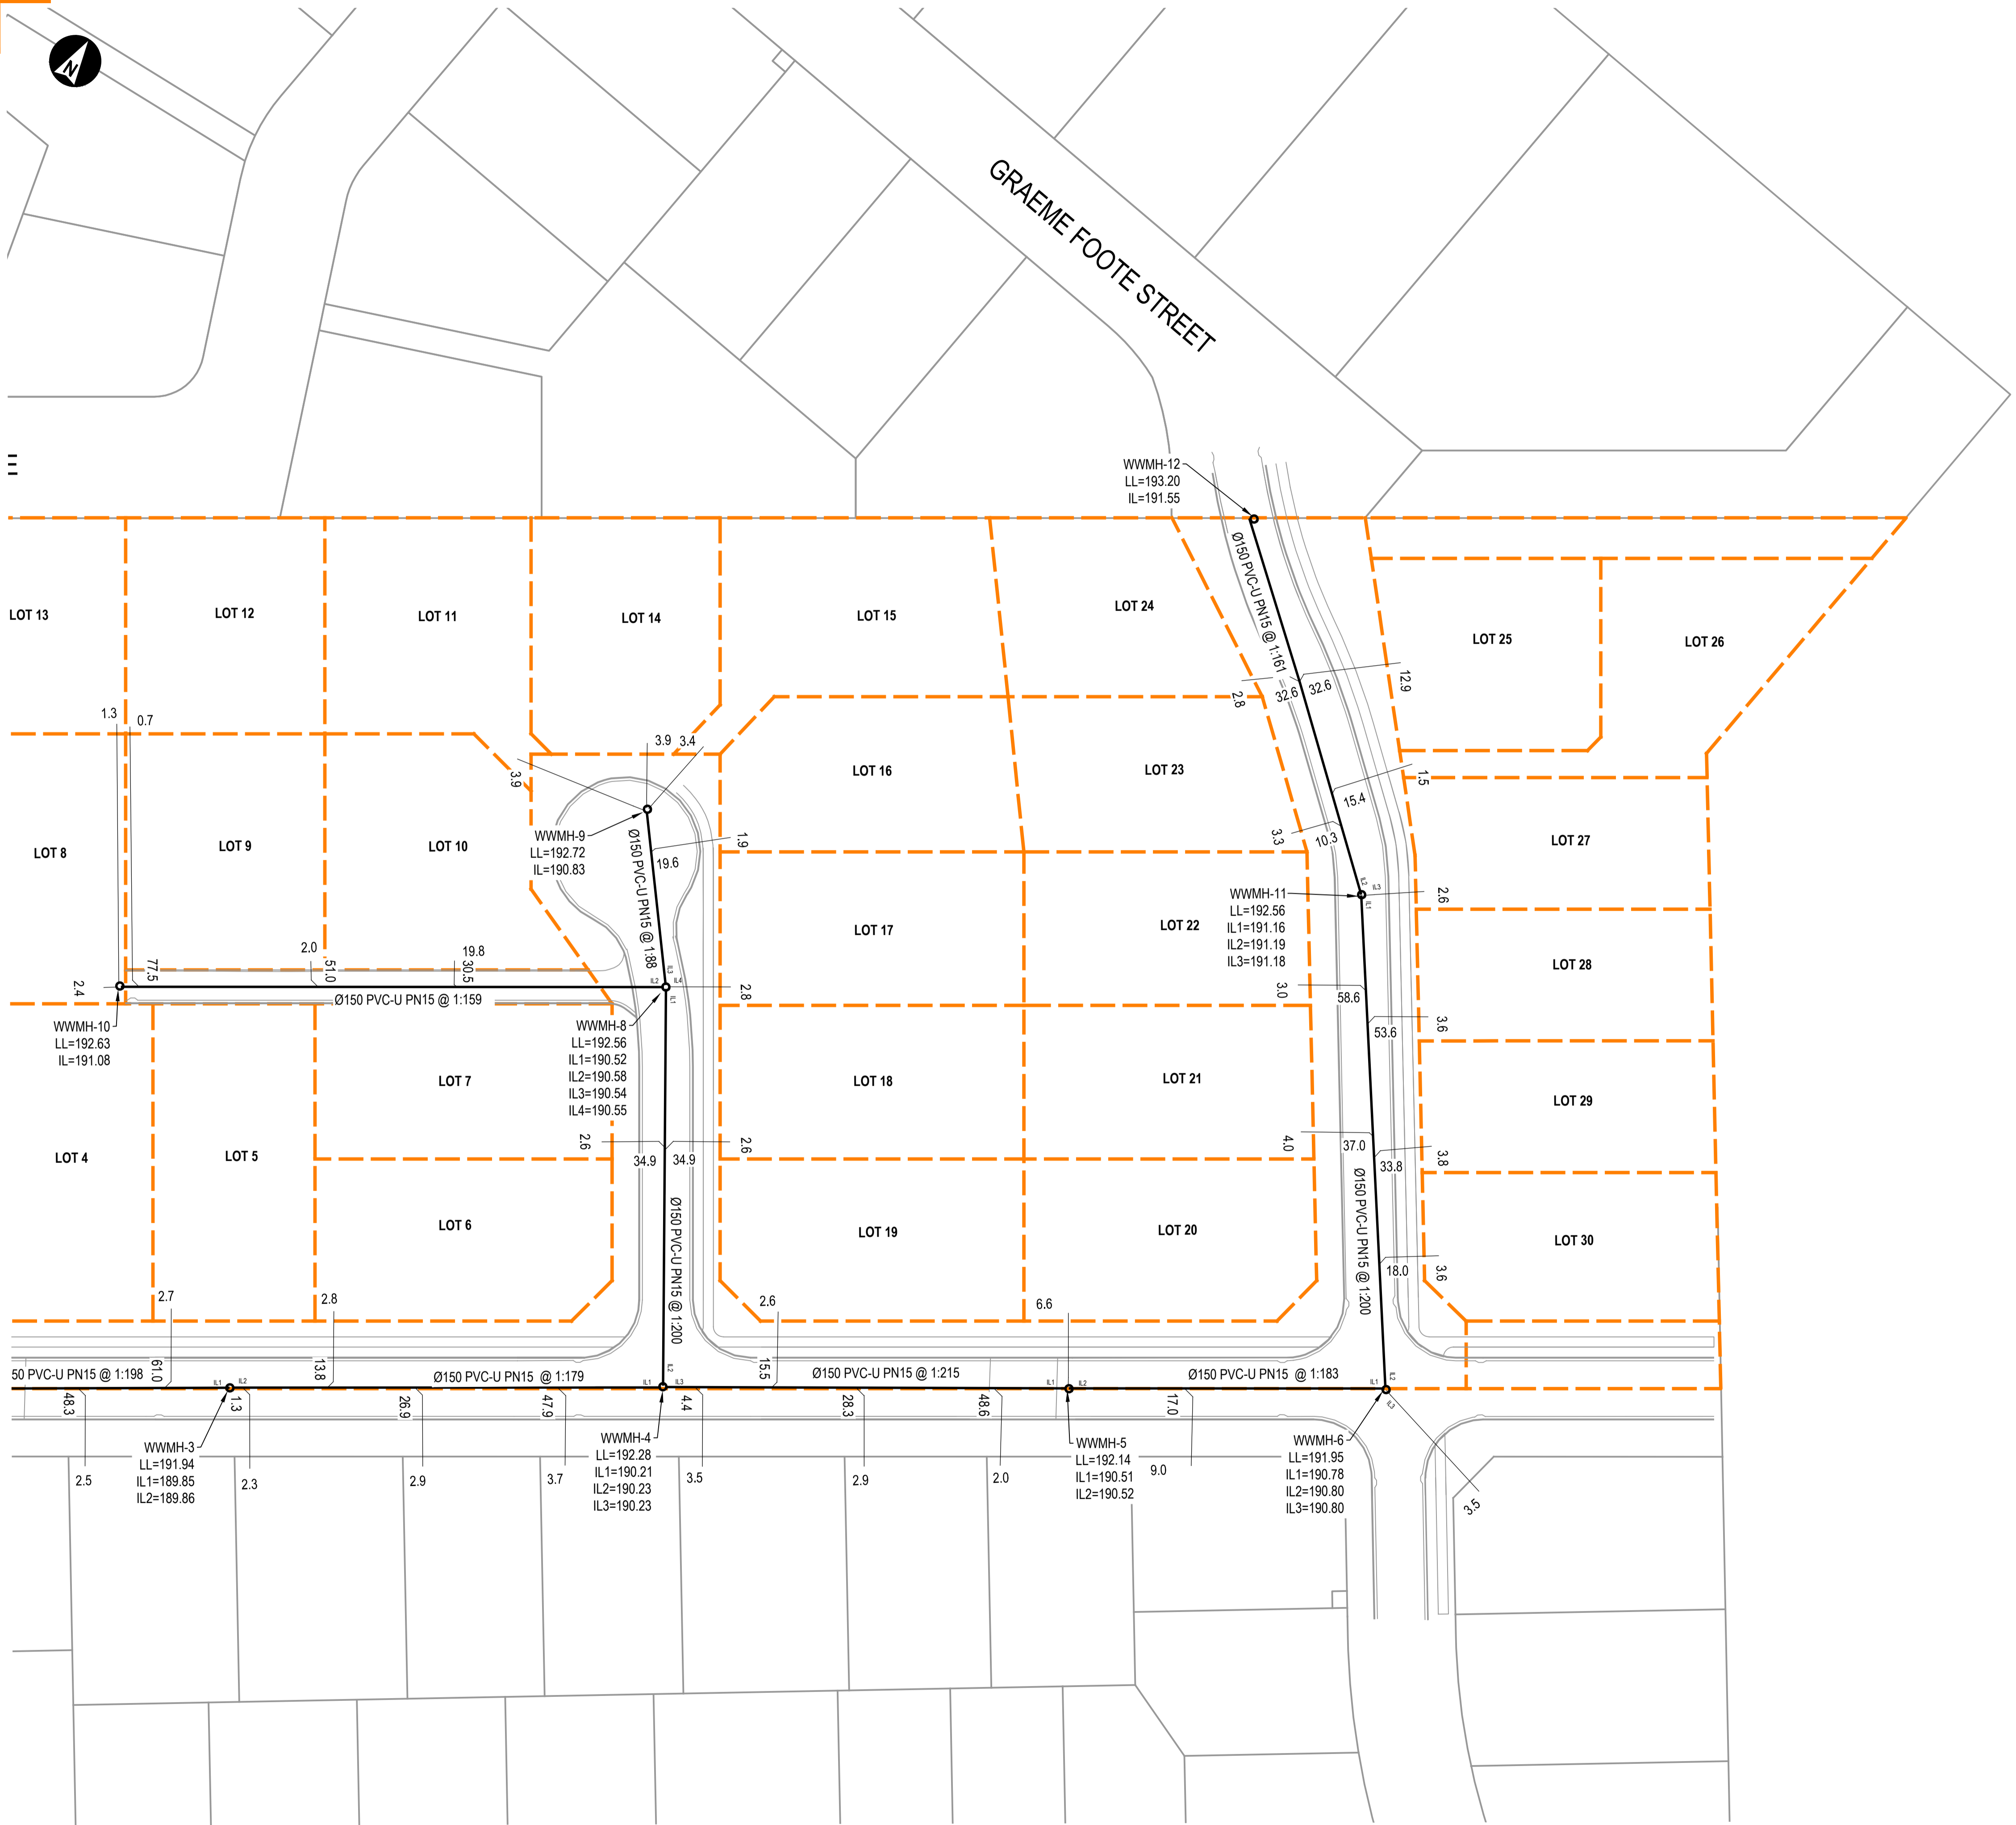

REV	DATE	ISSUED FOR	DM	BY
A	03-05-2022	AS BUILT		

PROJECT
1920 TELEGRAPH ROAD
DARFIELD

CLIENT
EAST WEST DEVELOPMENTS LTD

TITLE
WASTEWATER AS BUILTS
DRAWING 2 OF 2

REVIEWED BY: DM 03-05-2022



DESIGNED BY: BW

DRAWN BY: BW

SCALE: 1:500 (A1) JOB NO.: 2110455

DRAWING NO.: WW_AB.2 REV: A

AS BUILT

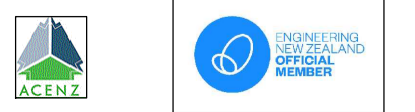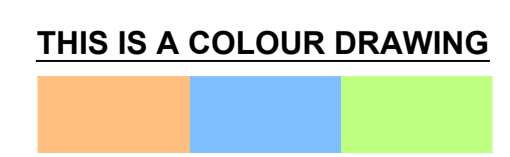

SCALE 1:500 (A1) 0 10 20 30 40 50m

Chief File: Z:\PROJ_2021\1045-1920_TelegraphRd\ROADS_DELIVERY\8_DRAFT\DWG\1920455-WW_AB.DWG Per Date: 5/10/2022 4:02:25 pm. Name: Ben Williams Xref: