

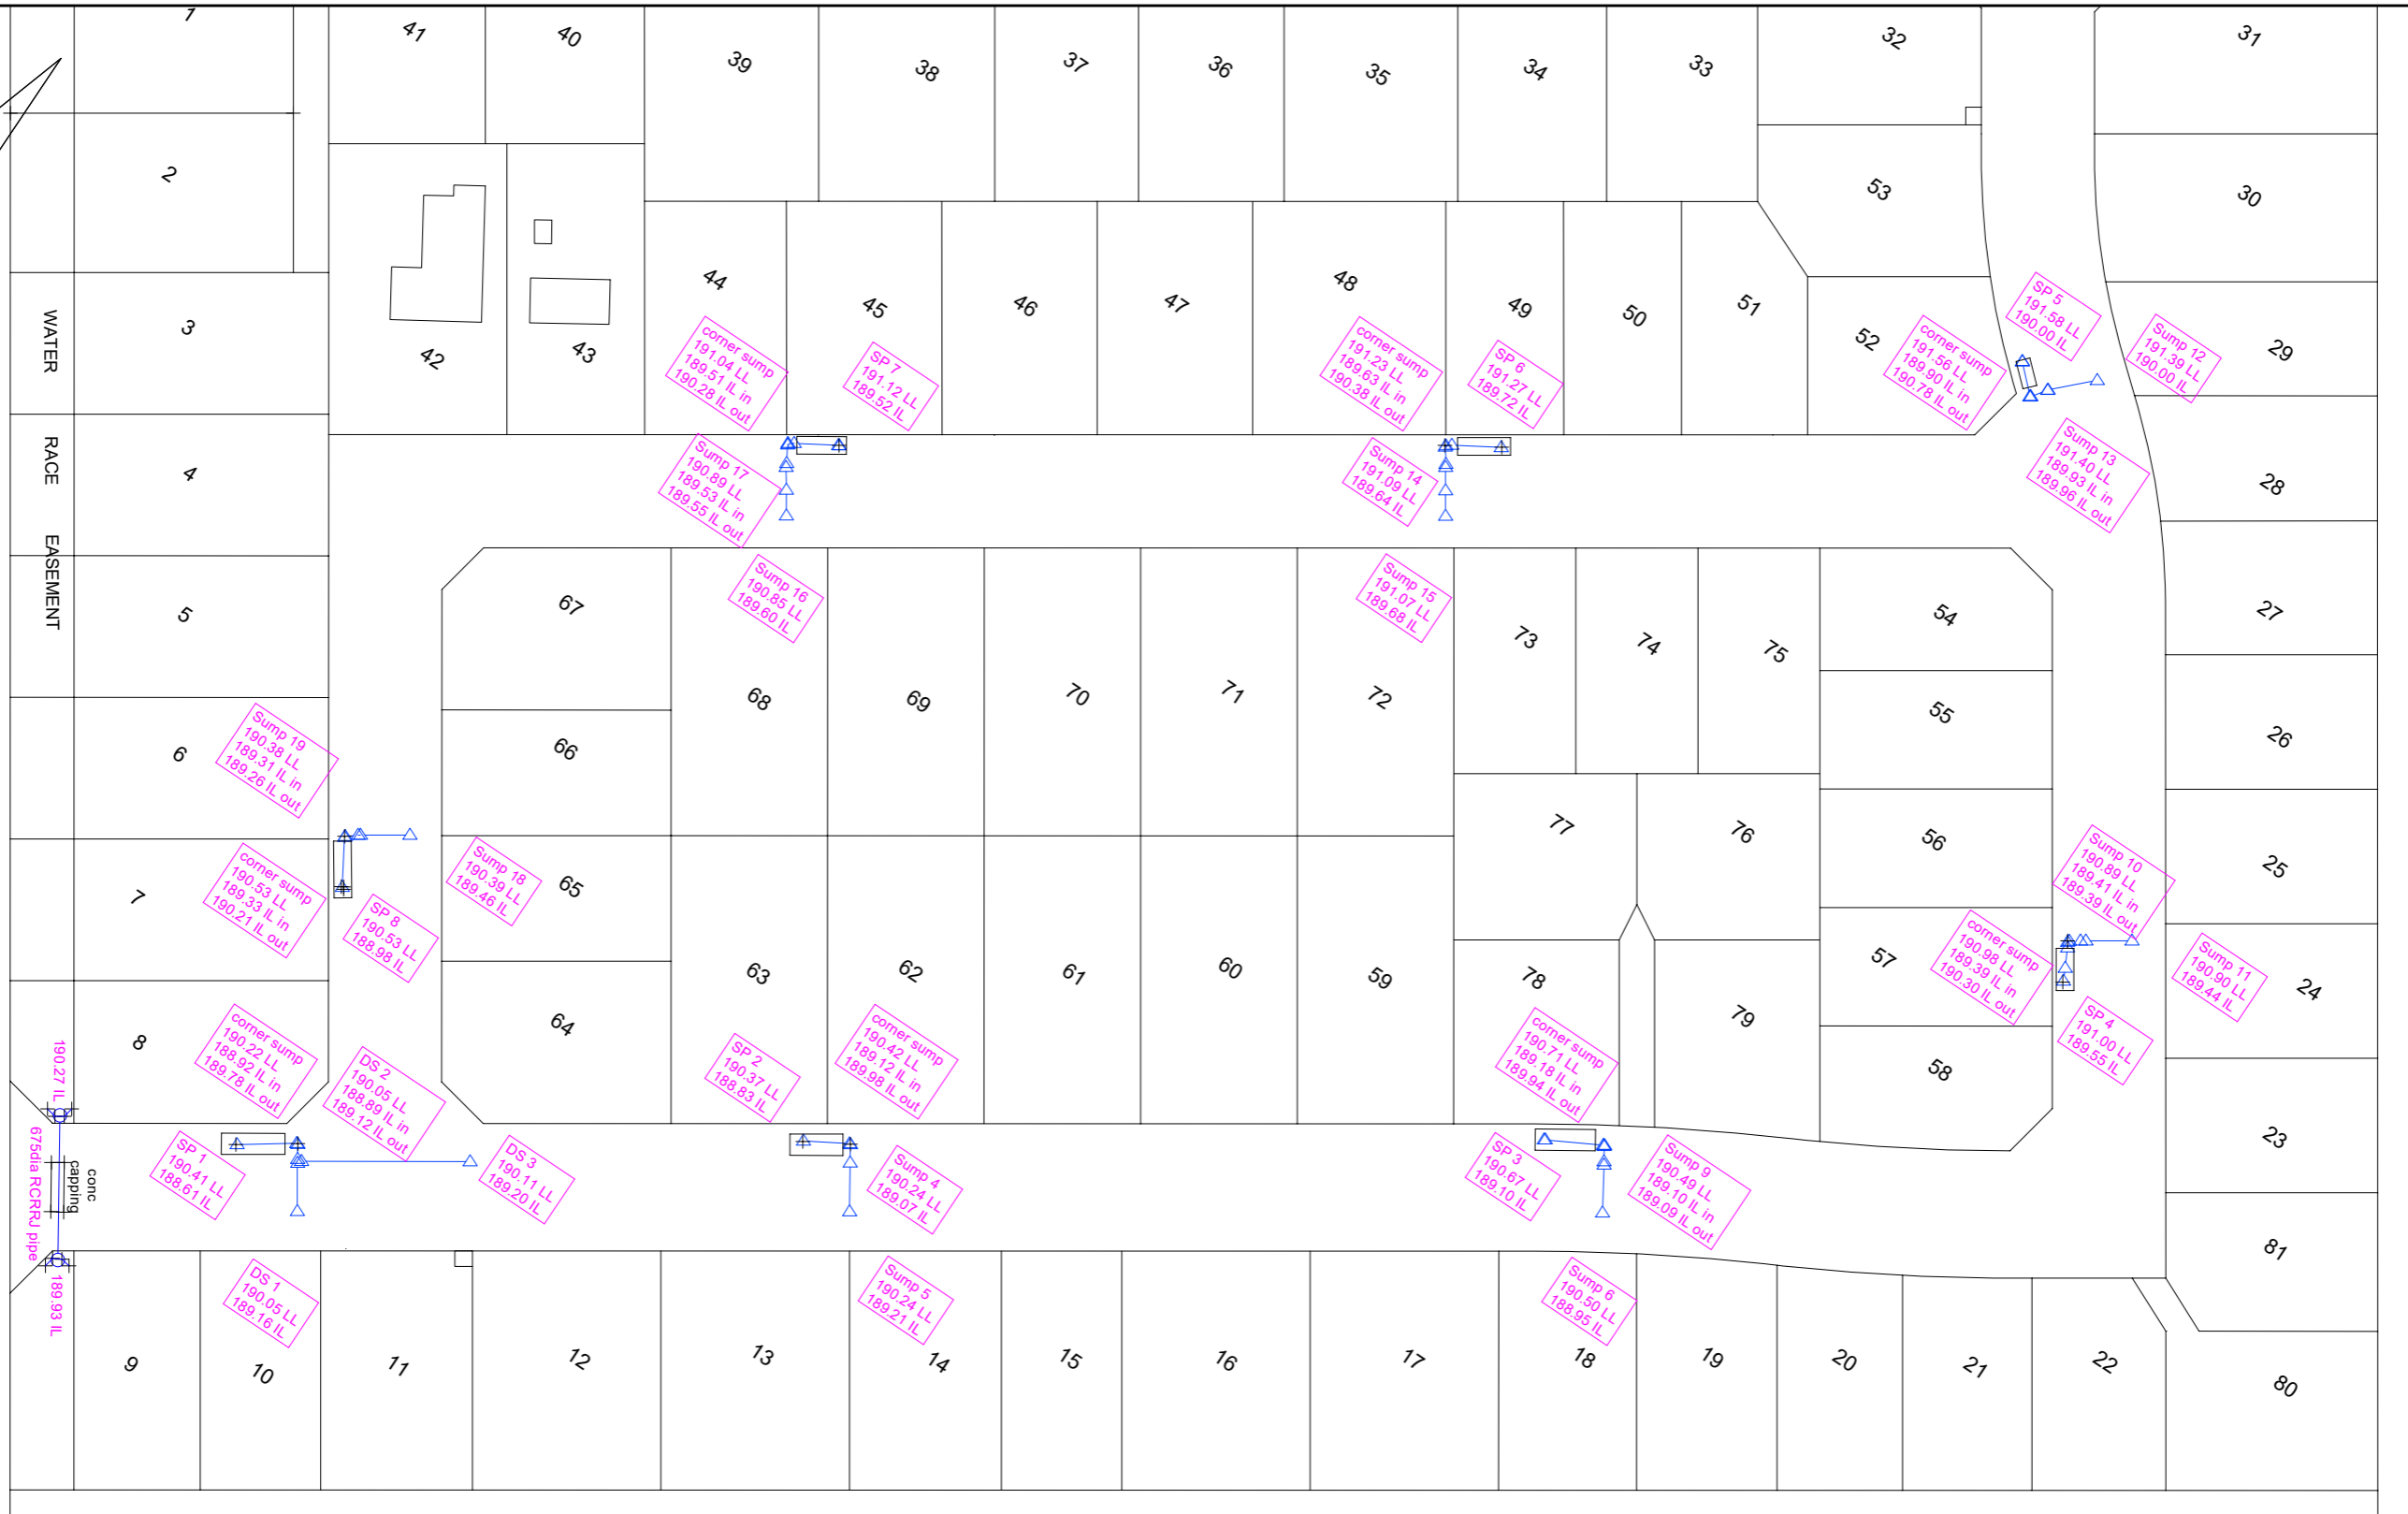



TELEGRAPH ROAD

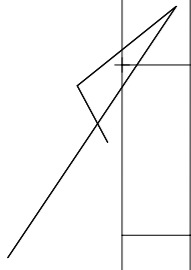

1  
DP 56120

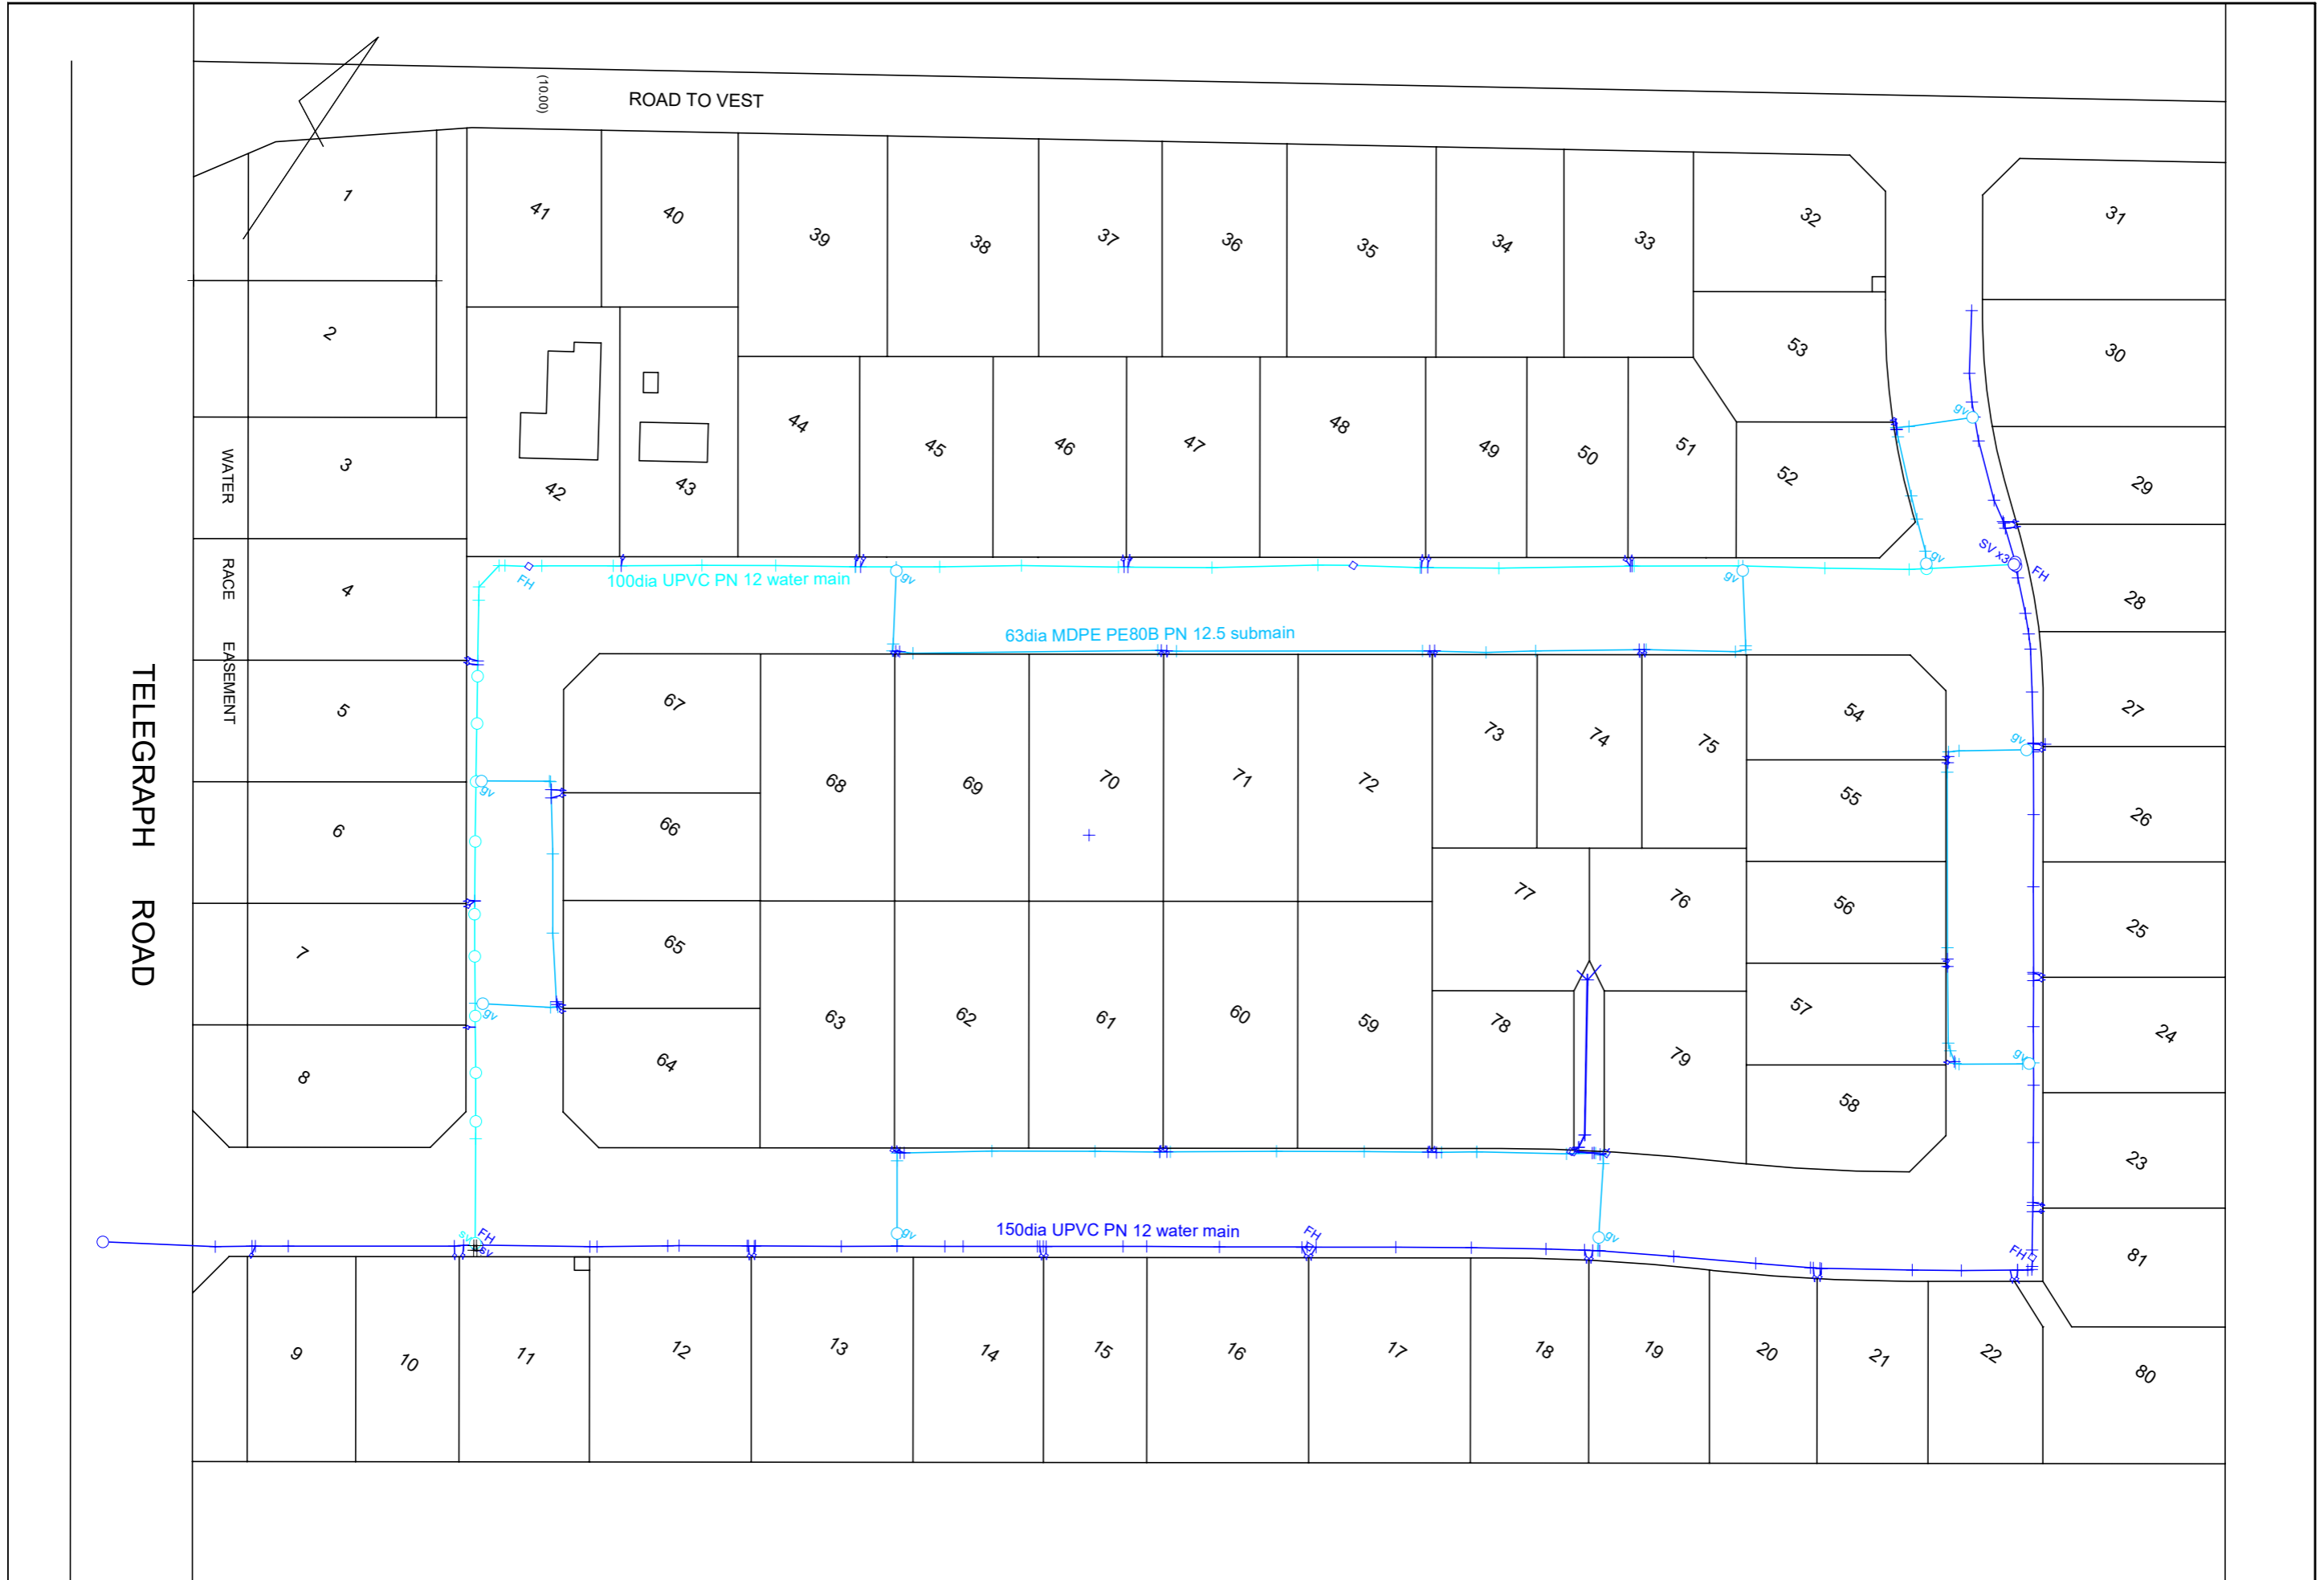

TELEGRAPH ROAD

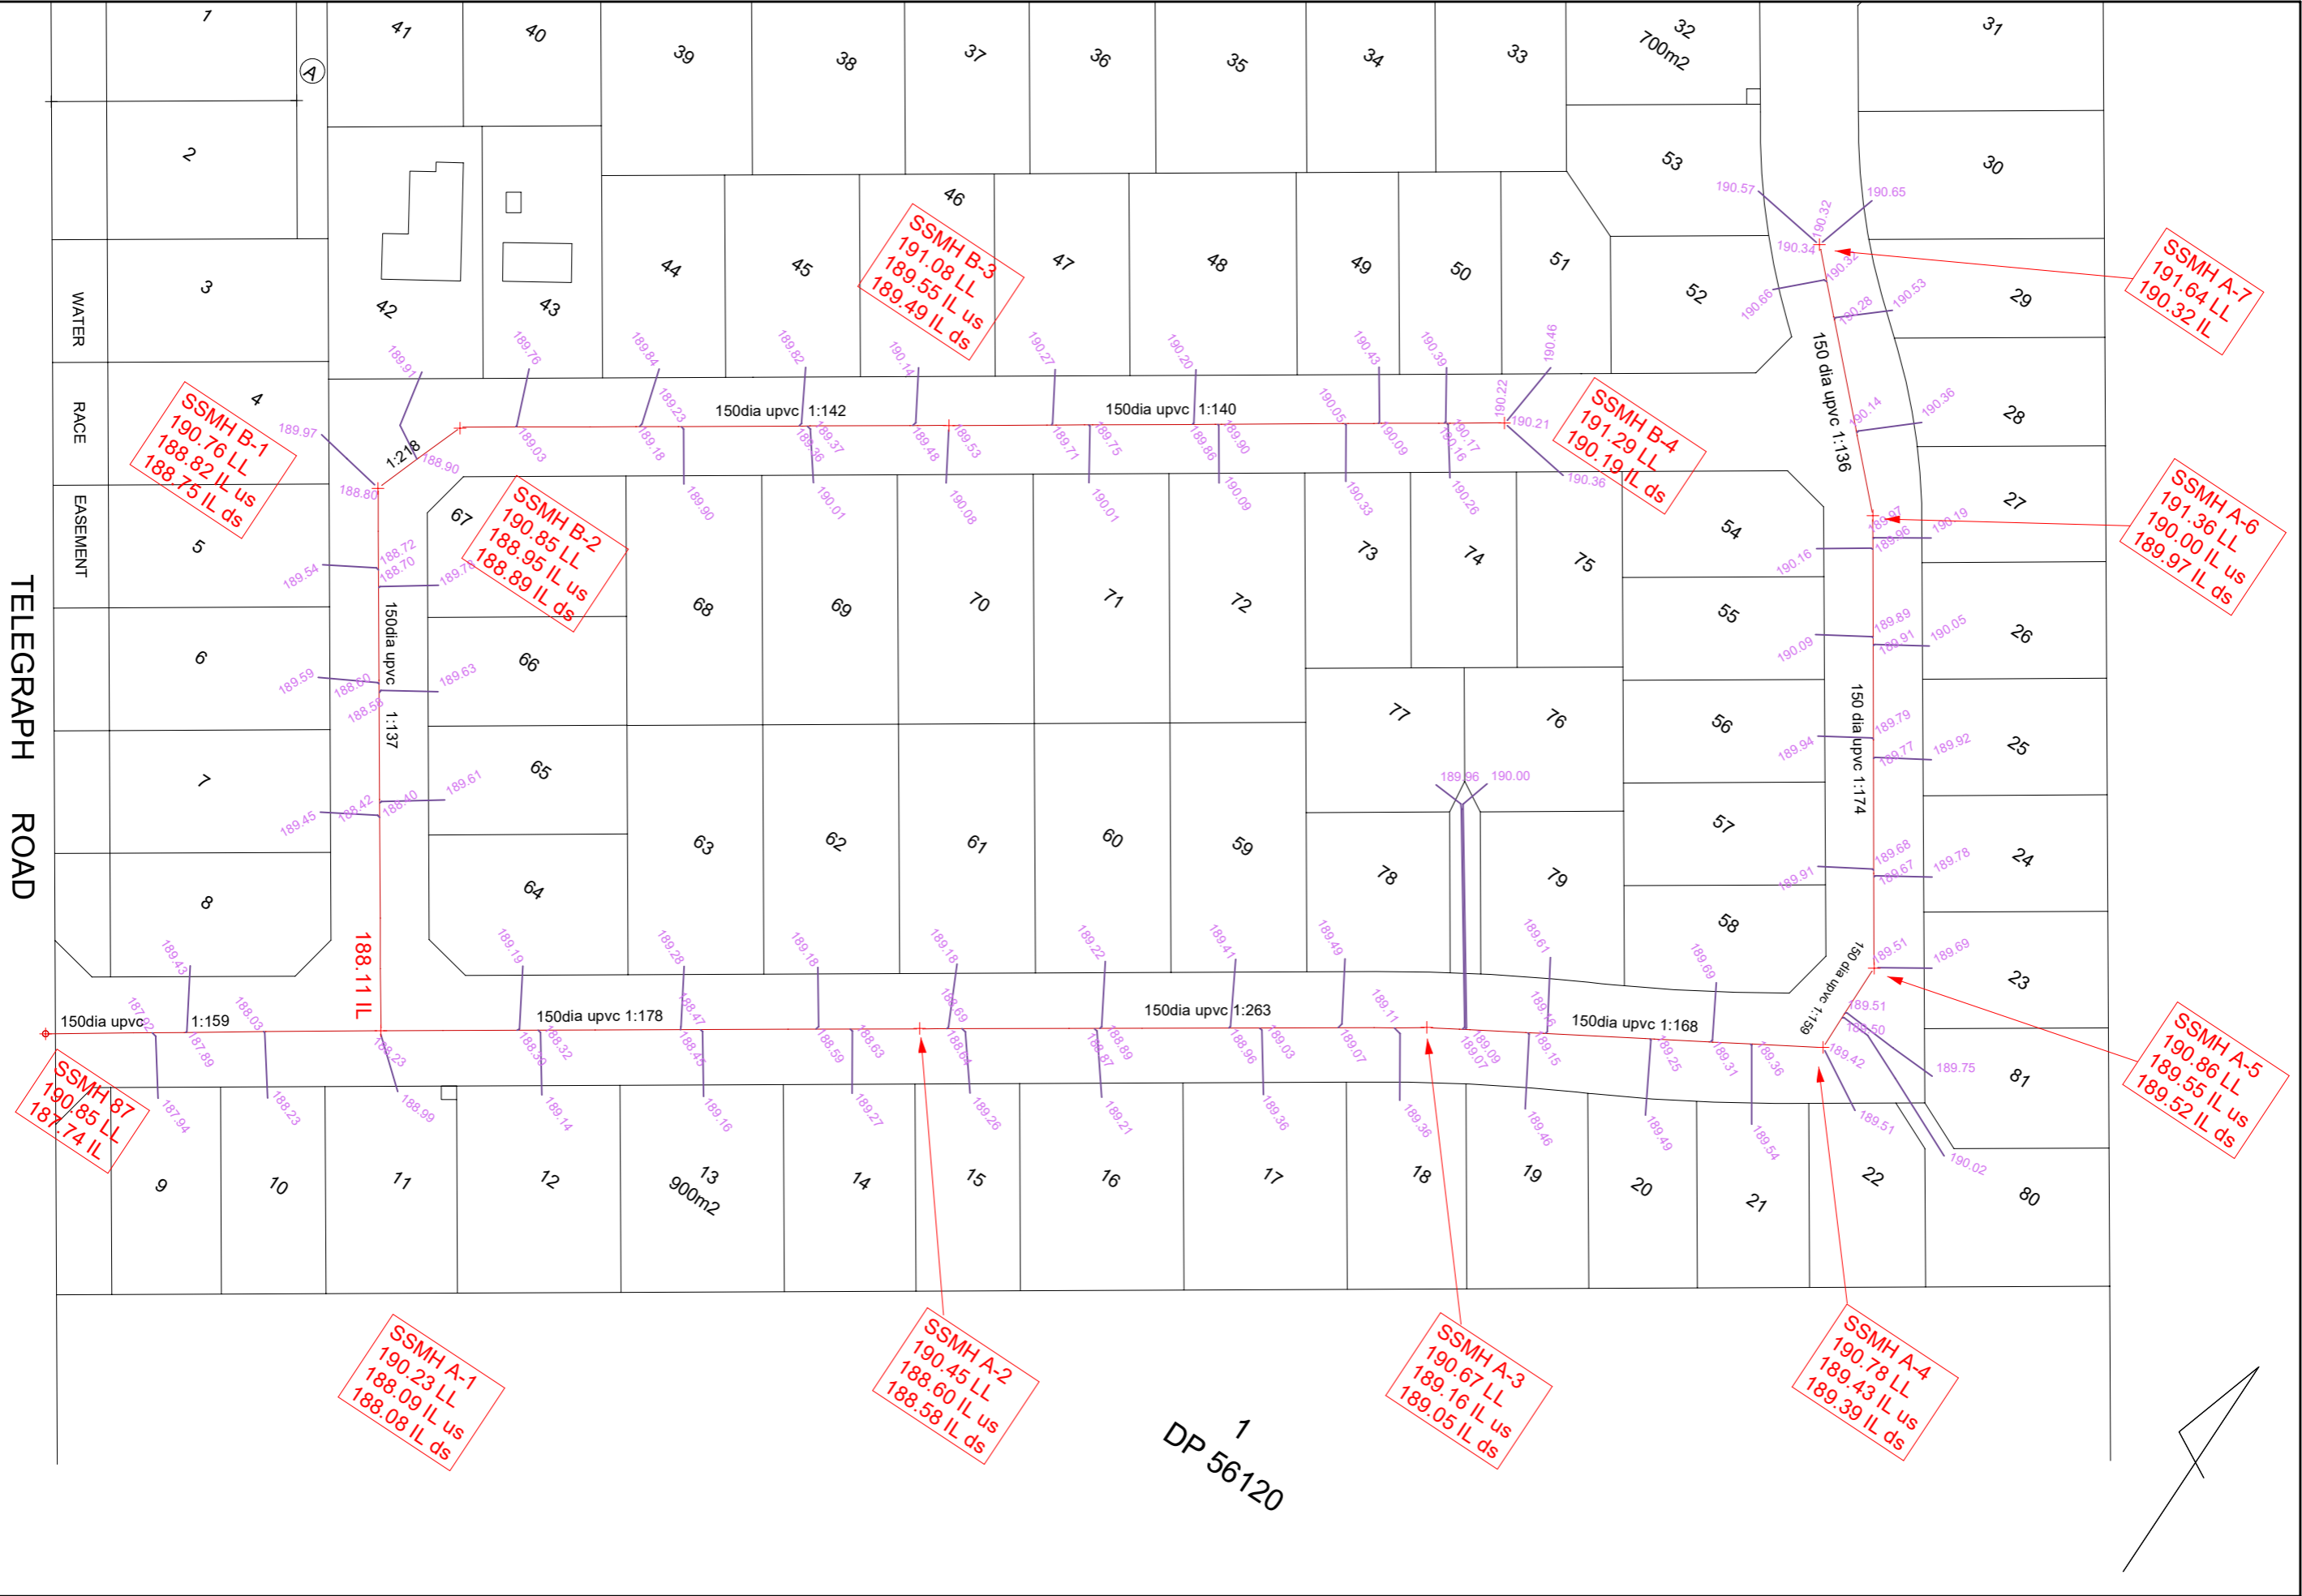

1  
DP 56120

